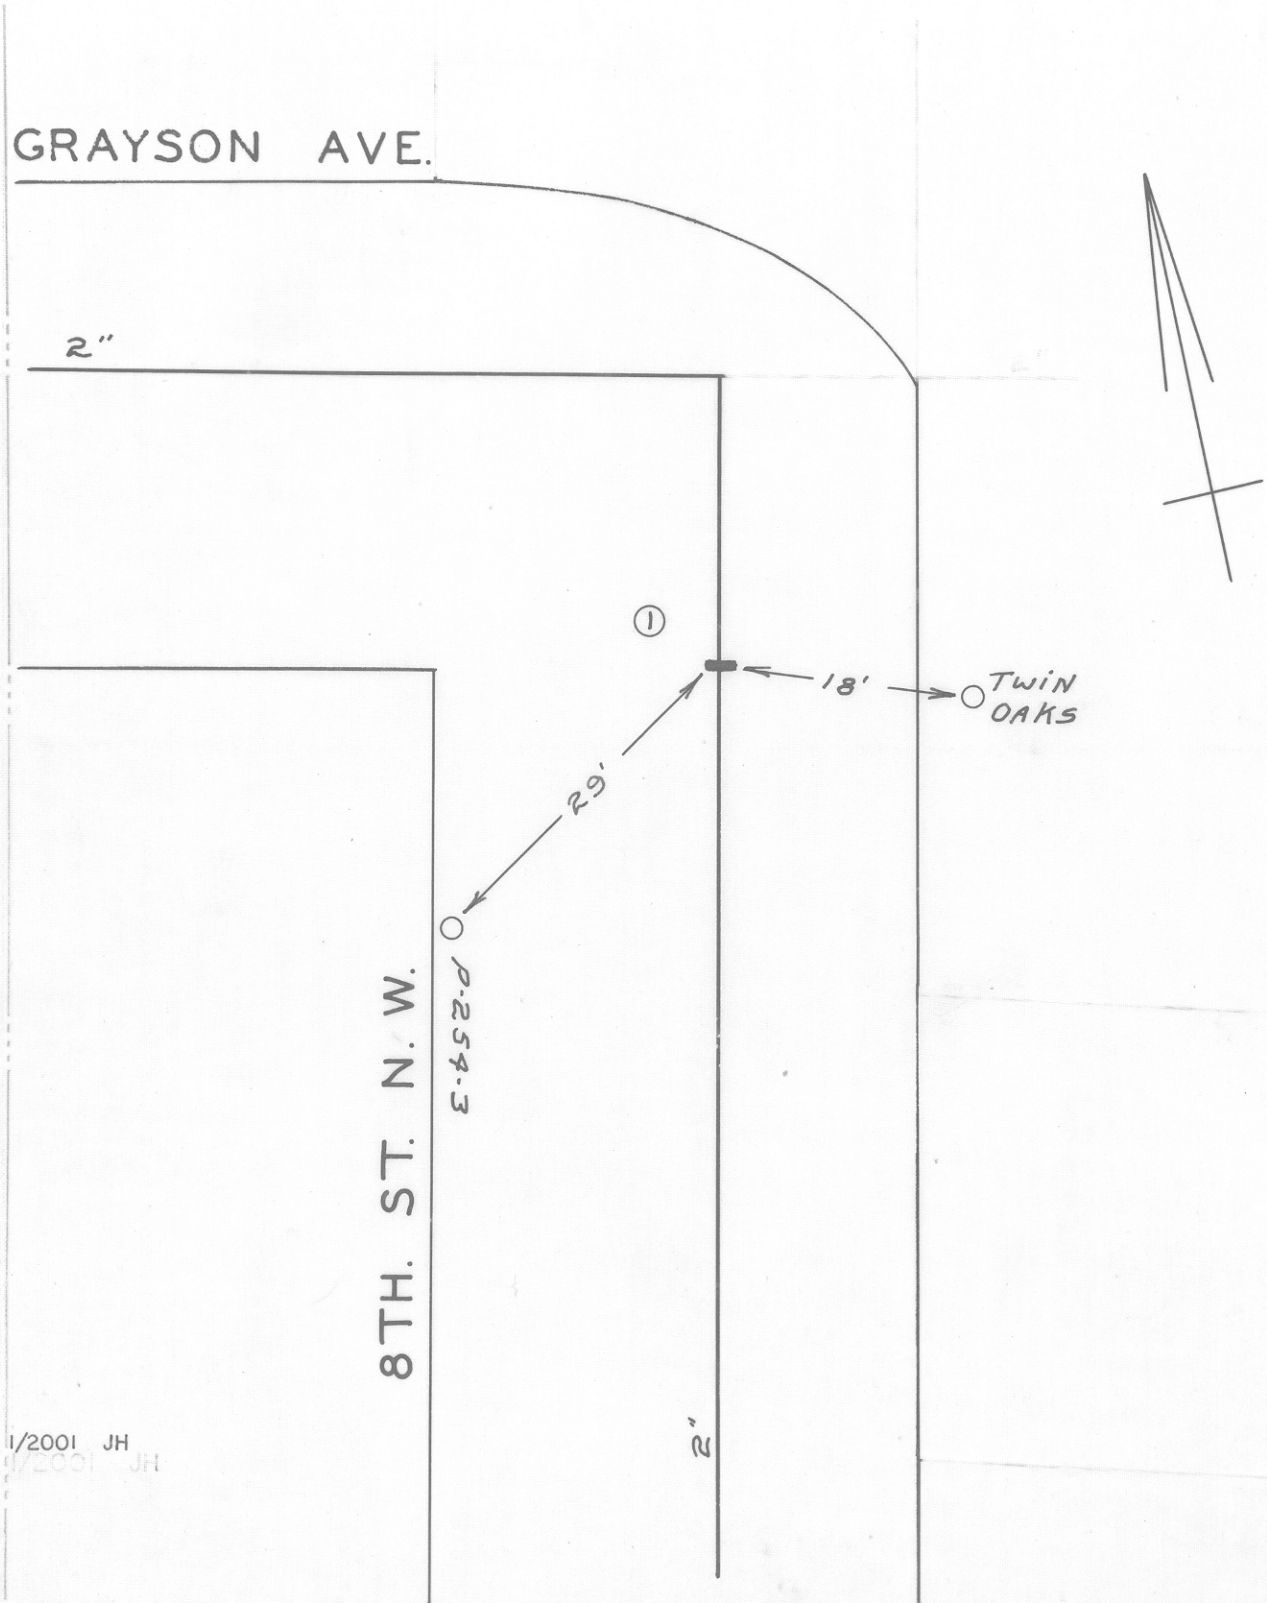

DATE	NO.	SIZE	MAKE	OPEN	TURNS
1996	1	2"		L	8

CITY OF ROANOKE—WATER DEPT.

VALVE DIAGRAM

GRAYSON AVE. & 8TH. ST.

8 th. STREET

SEC. MAP 203 N.W.

DATE PAGE NO.

1/2001 JH

"IMPERIAL" TRACING CLOTH K & E CO., N.Y.