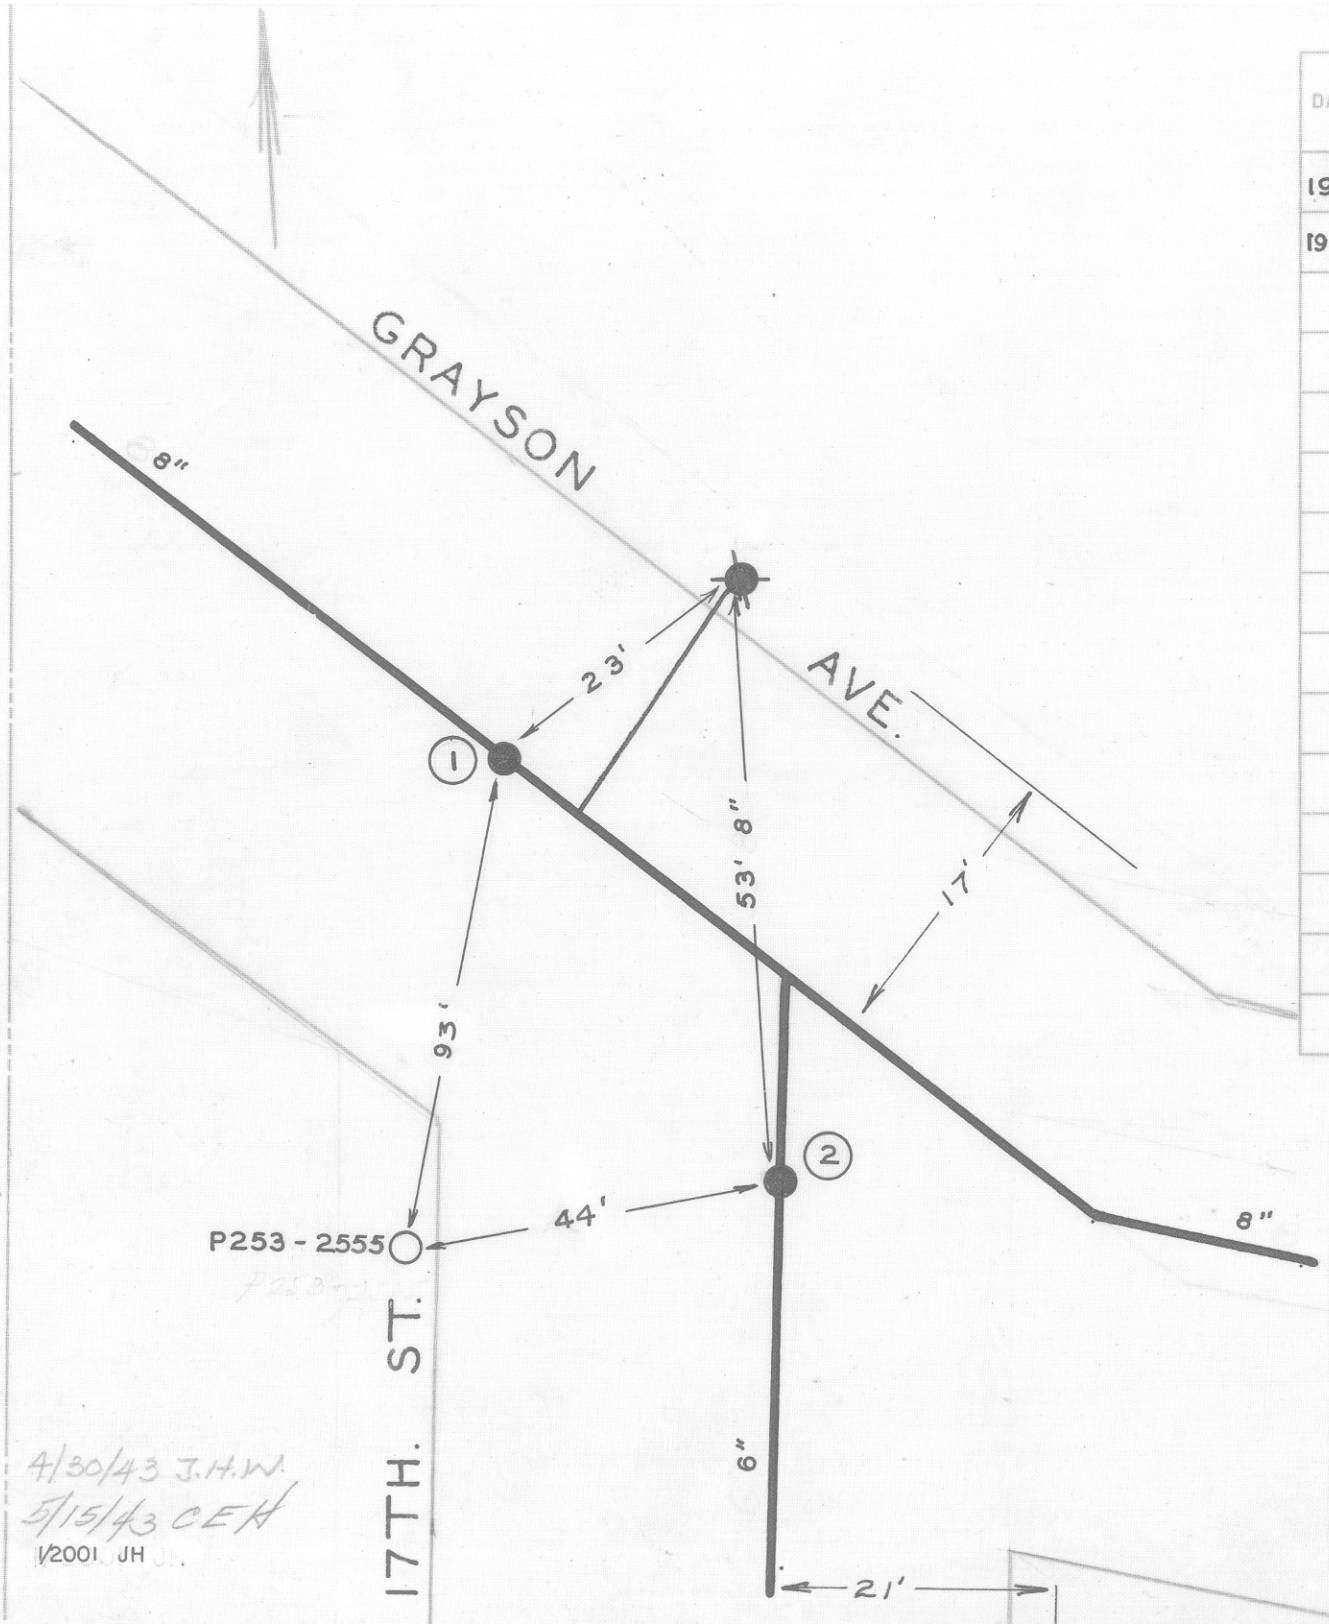


| DATE | NO. | SIZE | MAKE | OPEN | TURNS |
|---|---|---|---|---|---|
| 1939 | 1 | 8" | | R | 27 |
| 1939 | 2 | 6" | | R | 20 1/2 |
| | | | | | |
| | | | | | |
| | | | | | |
| | | | | | |
| | | | | | |
| | | | | | |
| | | | | | |
| | | | | | |
| | | | | | |
| | 1 | 0 | WPL | | |
| | 2 | 20'-N | SPL | | |
| | | | | | |

CITY OF ROANOKE—WATER DEP'T

VALVE DIAGRAM

GRAYSON AVE. & 17TH

17 TH STREET

SEC. MAP 233 N.W.

DATE PAGE NO. NW 236

4/30/43 J.H.W.
5/15/43 CEH
1/2001 JH