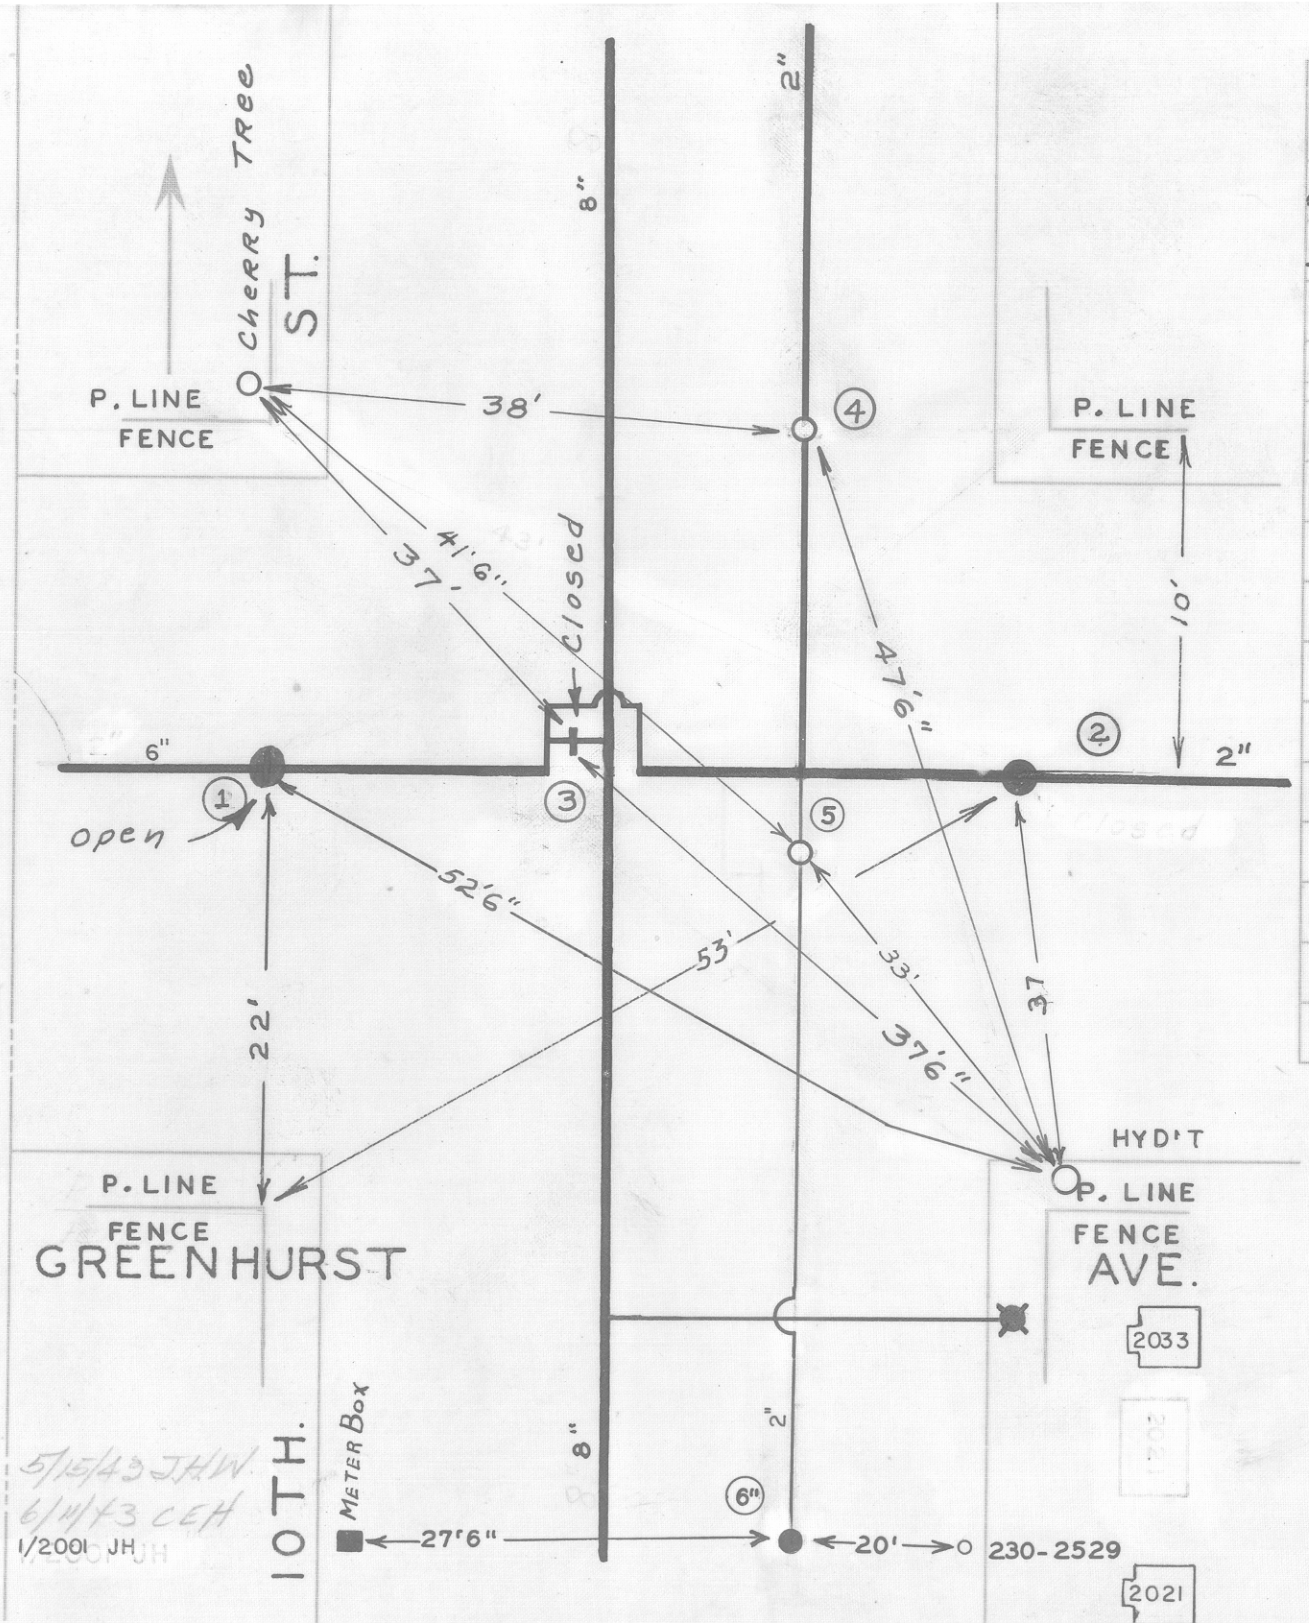

DATE	NO.	SIZE	MAKE	OPEN	TURNS
1942	1	2"		L	9 1/2
1950	2	2"	DARLING	R	7 1/2
'58	3	2"	MISC.	L	7
'58	4	2"	MISC.	L	7
10-62	5	2"	DARLING	R	
10-62	6	2"	MISC.	L	
	1	5'E	WPL		
	2	5'E	EPL		
	3	11'W	EPL		
	4	0	NPL		

CITY OF ROANOKE—WATER DEP'T

VALVE DIAGRAM

GREENHURST AVE. & 10TH. STREET

SEC. MAP 214 N.W.

DATE PAGE NO. NW. 68