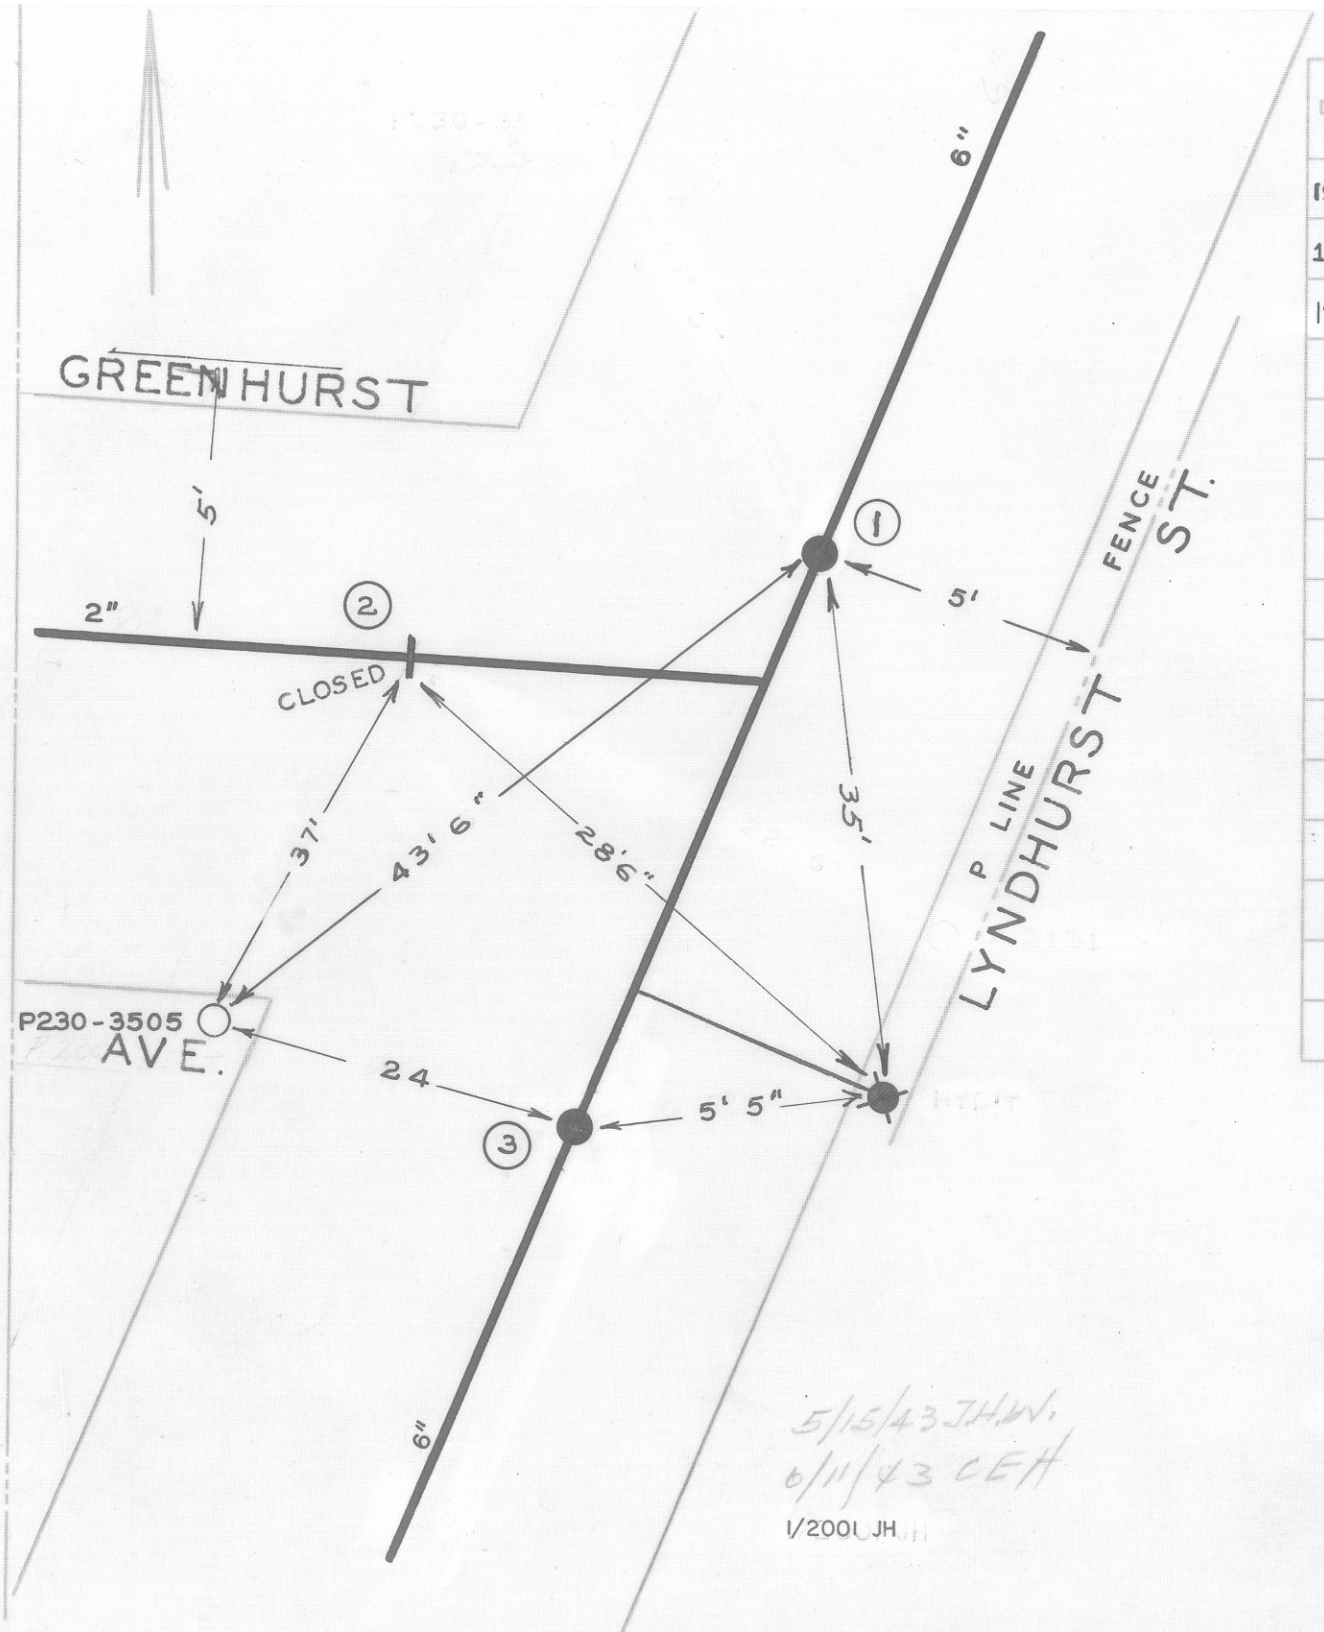


| DATE | NO. | SIZE | MAKE | OPEN | TURNS |
|---|---|---|---|---|---|
| 1925 | 1 | 6" | | R | 21 |
| 1949 | 2 | 2" | K. & J. | R | 8 1/2 |
| 1953 | 3 | 6" | MUELLER | R | 20 |
| | | | | | |
| | | | | | |
| | | | | | |
| | | | | | |
| | | | | | |
| | | | | | |
| | | | | | |
| | | | | | |
| | 1 | 0 | NPL | | |
| | 2 | 29'-E | WPL | | |
| | 3 | 9'-S | SPL | | |
| | | | | | |

CITY OF ROANOKE—WATER DEP'T

VALVE DIAGRAM

GREENHURST AVE. &

LYNDHURST ST.

SEC. MAP 206 N.W.

DATE PAGE NO. N.W. 69