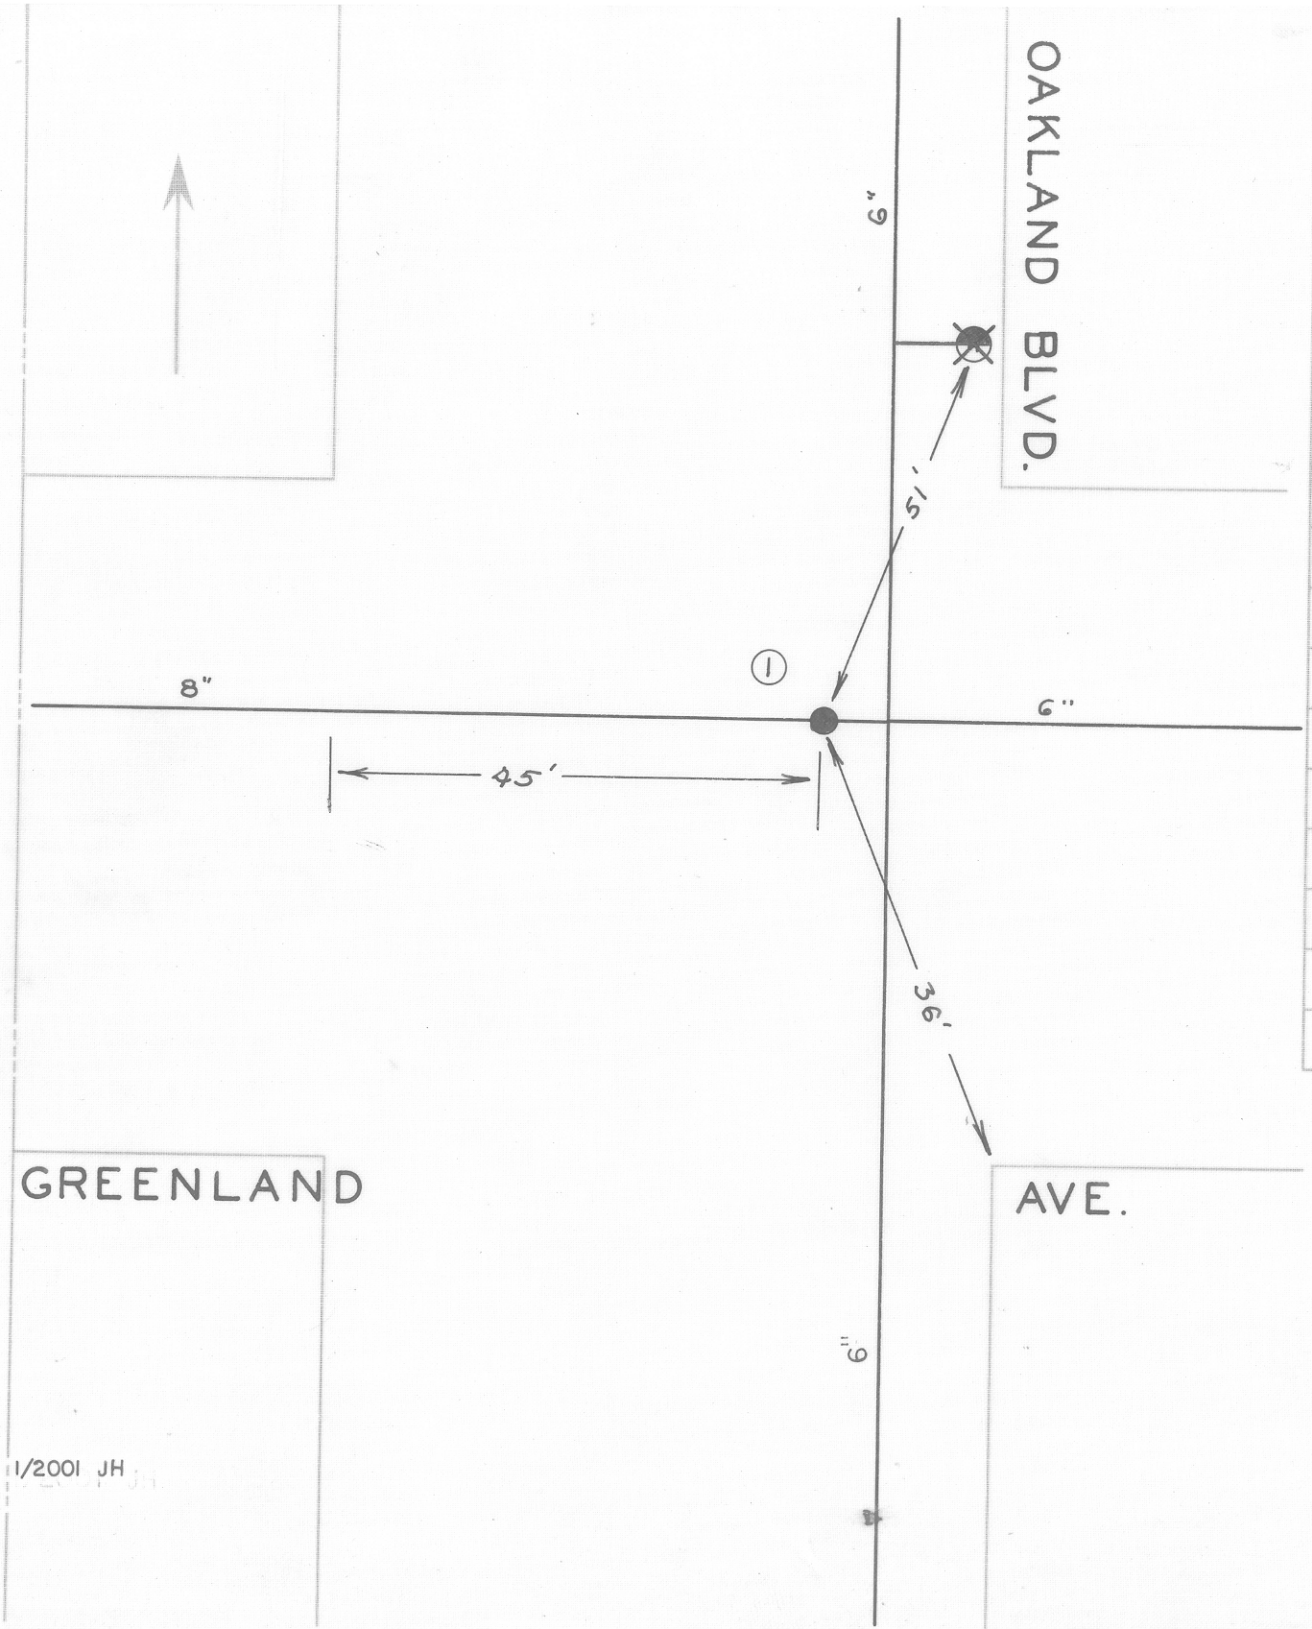

DATE	NO.	SIZE	MAKE	OPEN	TURNS
1955	1	6"	MUELLER	R	21
	1	45'-E OF WPL			

CITY OF ROANOKE—WATER DEP'T

VALVE DIAGRAM

GREENLAND AVE. &

OAKLAND BLVD. N.W.

SEC. MAP 215 N.W.

DATE PAGE NO.

1/2001 JH