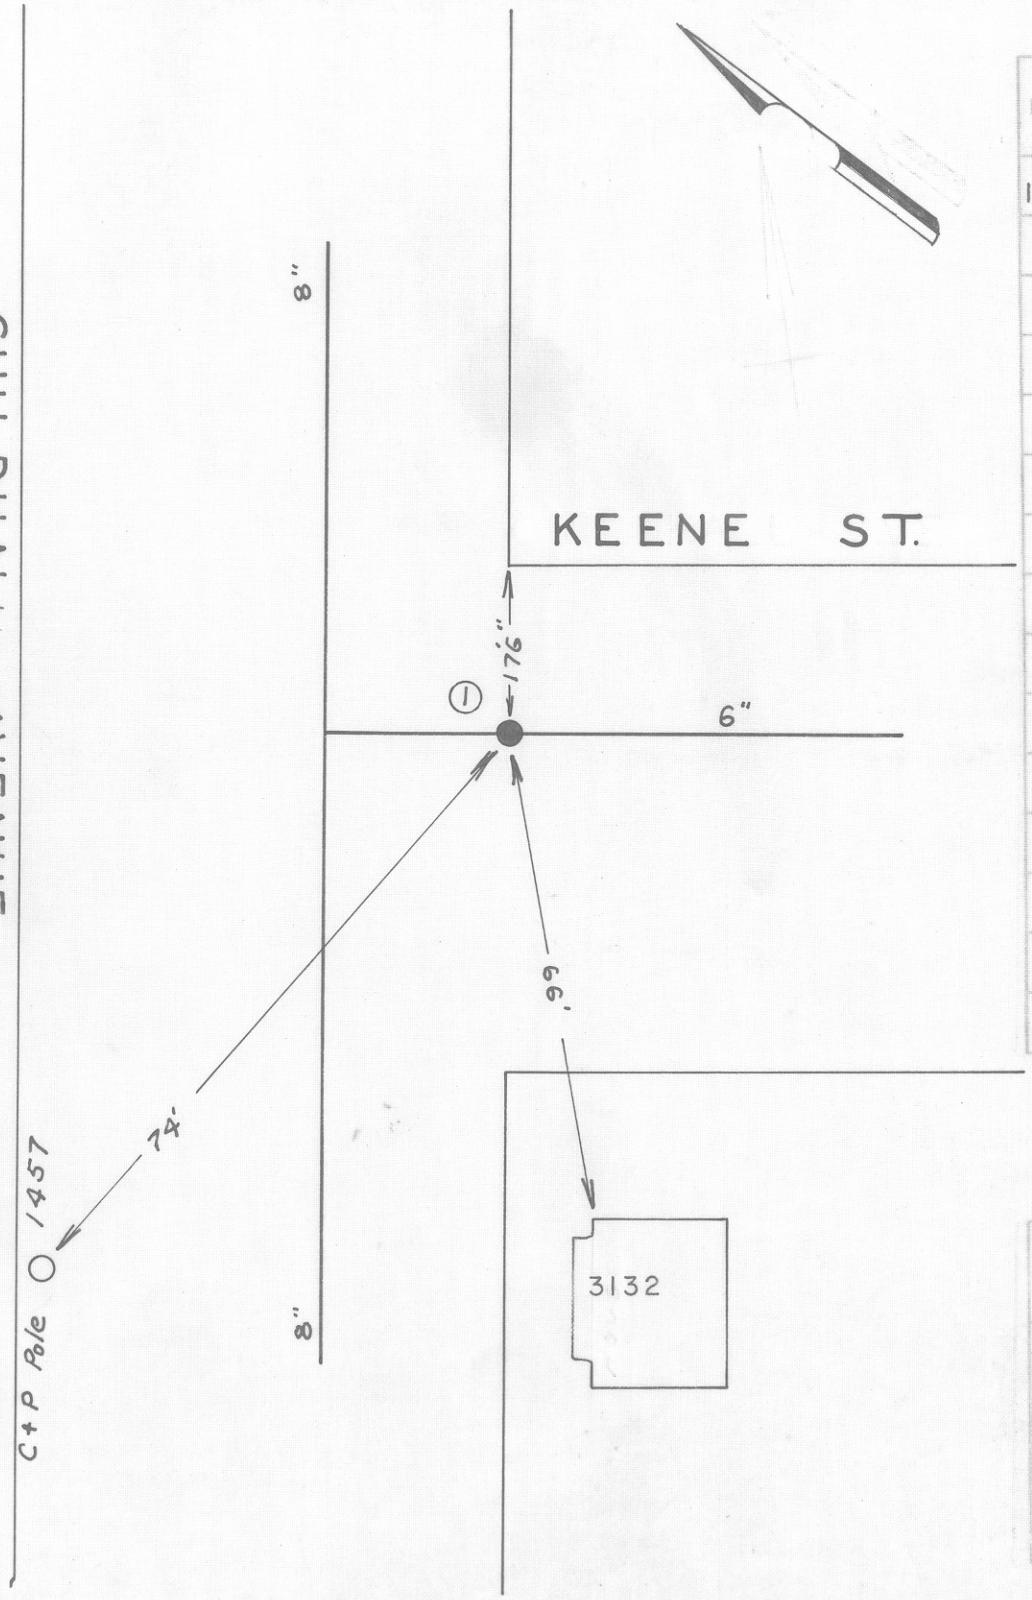

DATE	NO.	SIZE	MAKE	OPEN	TURNS
1956	1	6"	MUELLER	R	21
	1	0	EPL		

CITY OF ROANOKE — WATER DEPT.

VALVE DIAGRAM

GUILDHALL AVE. &

KEENE ST. N. W.

SEC. MAP 246 N.W.

DATE PAGE NO.

12/2000 JH

"IMPERIAL" TRACING CLOTH K & E CO., N. Y.