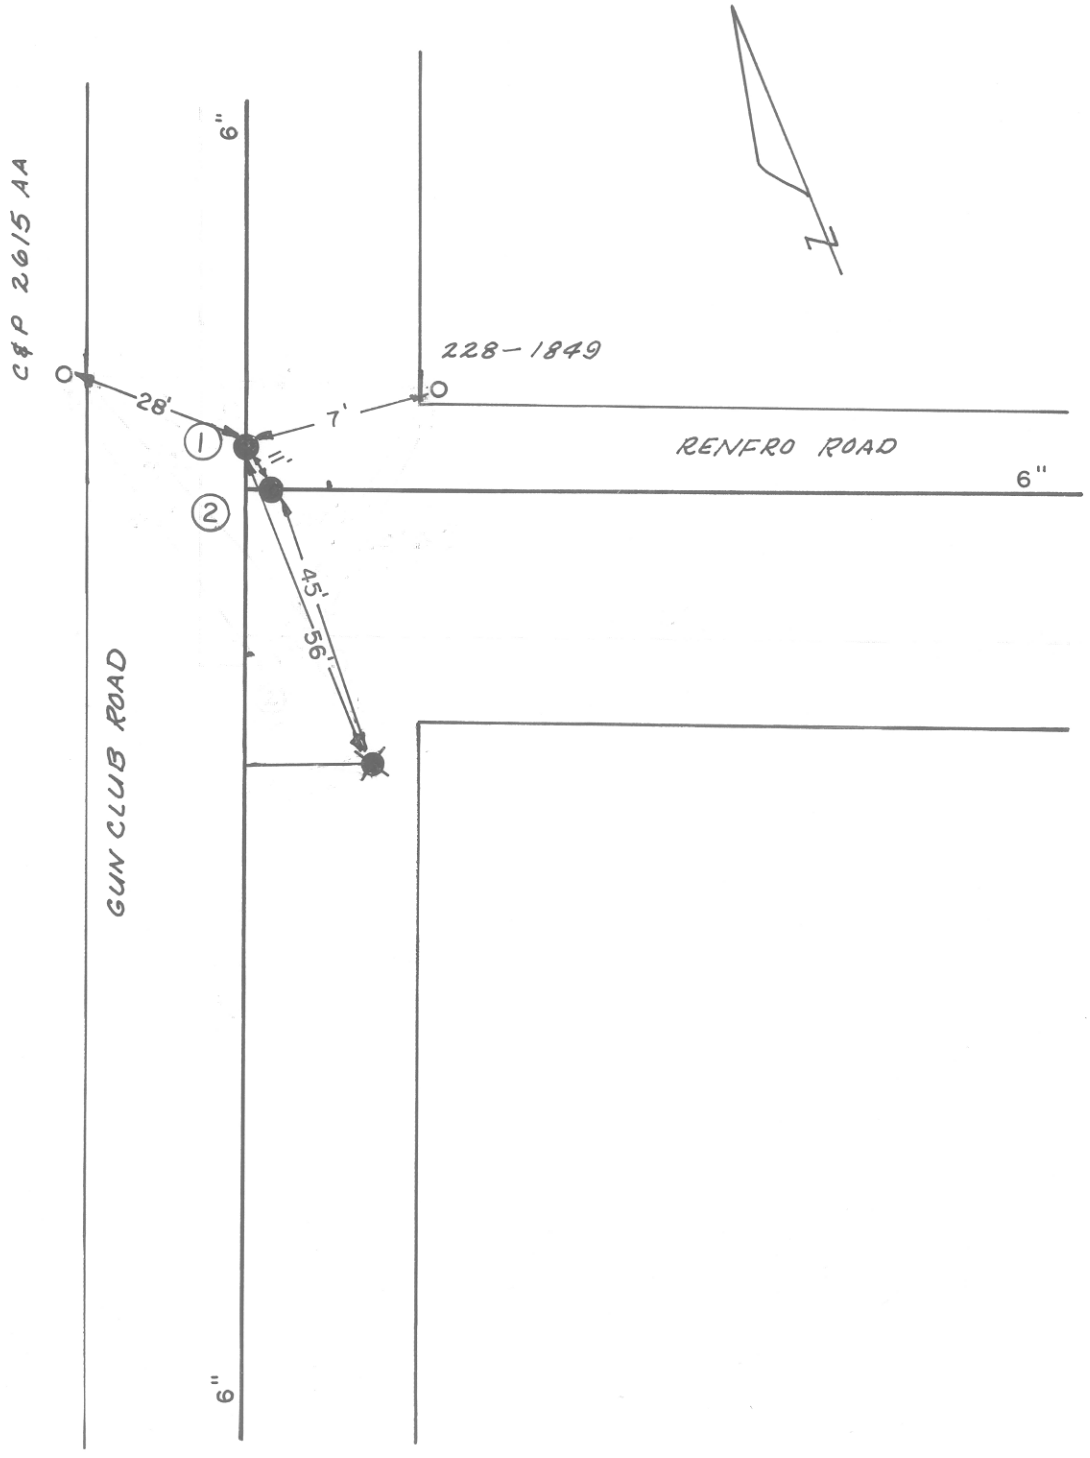

DATE	NO.	SIZE	MAKE	OPEN	TURNS
8-88	1	6"	MUELLER	R	21
8-88	2	6"	MUELLER	R	21

CITY OF ROANOKE—WATER DEP'T

VALVE DIAGRAM

GUN CLUB ROAD &

RENFRO ROAD N.W.

SEC. MAP

DATE 610, 611 PAGE NO

11/90 NP