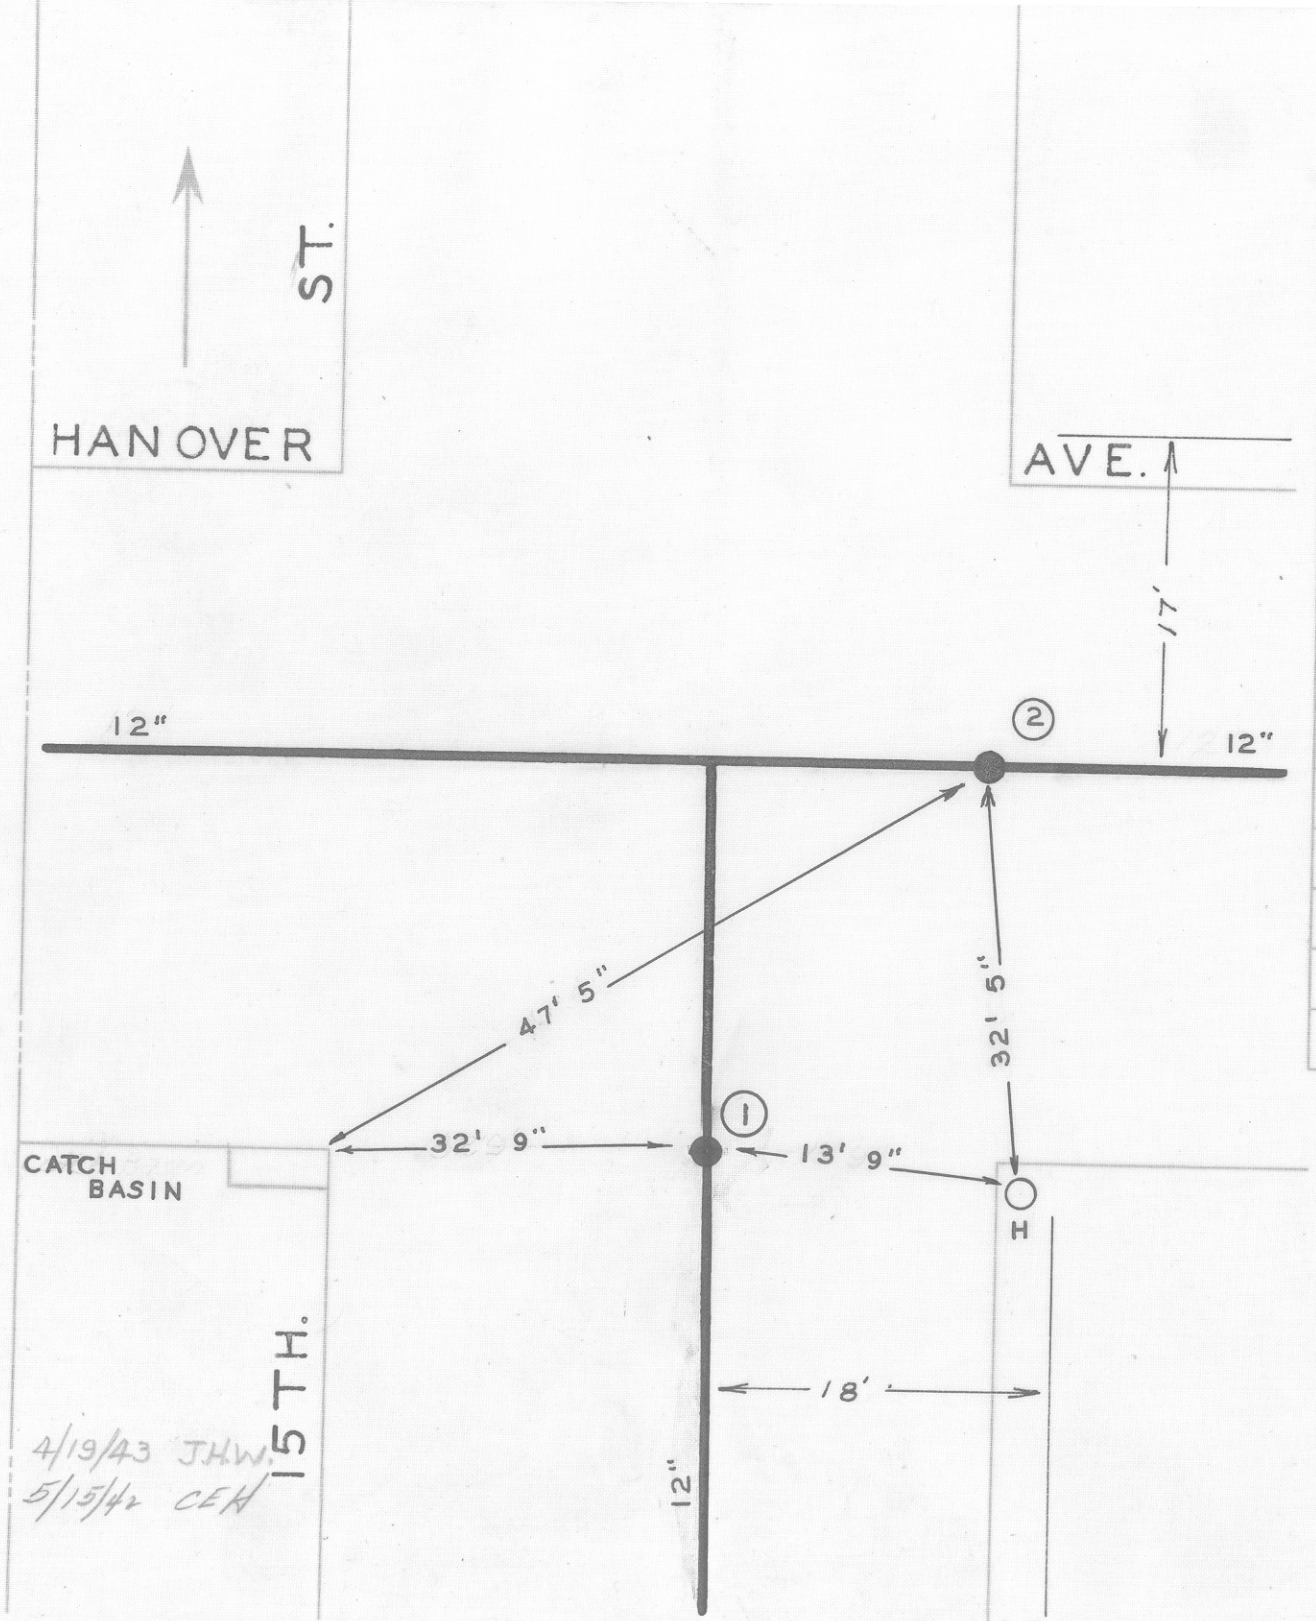

DATE	NO.	SIZE	MAKE	OPEN	TURNS
1926	1	12"		R	38 1/2
1939	2	12"		R	39
	1	10'-N	SPL		
	2	10'-W	EPL		

CITY OF ROANOKE—WATER DEP'T

VALVE DIAGRAM

HANOVER AVE. & 15TH. ST. N.W.

SEC. MAP 222

DATE

PAGE NO. N.W.154