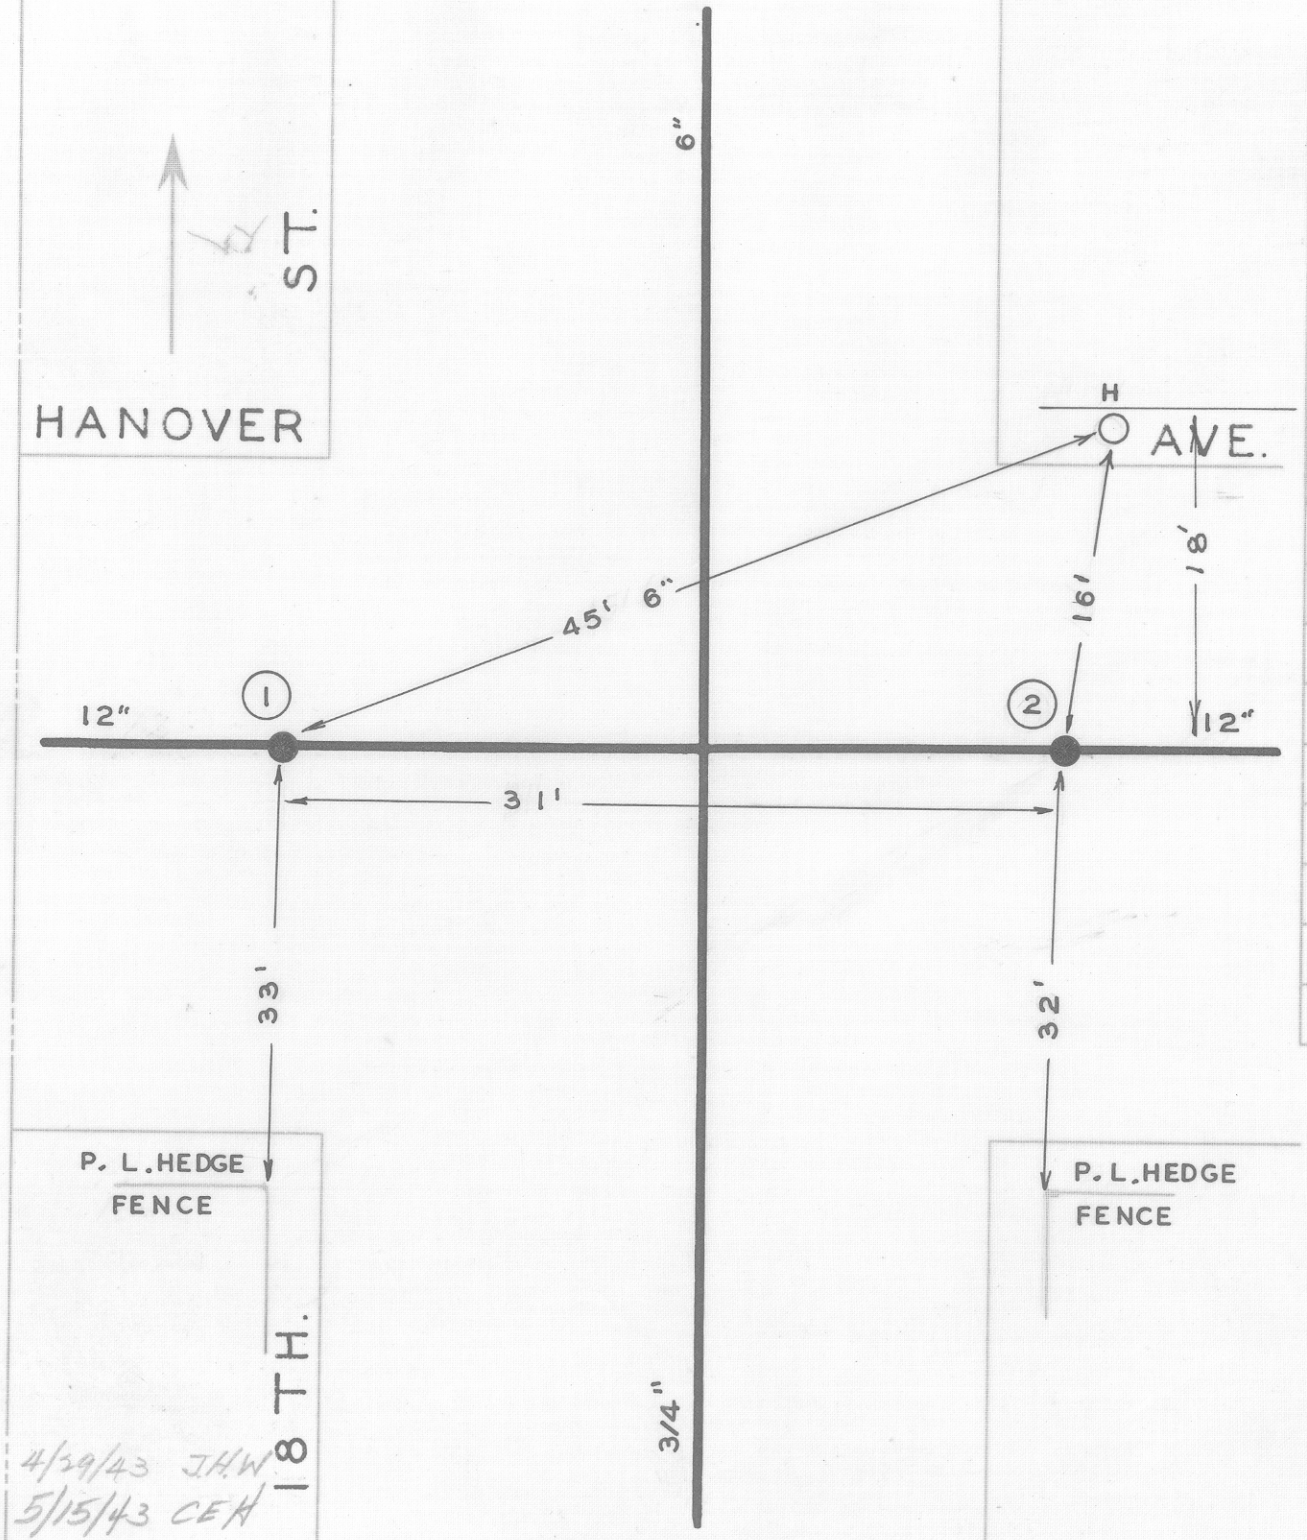

DATE	NO.	SIZE	MAKE	OPEN	TURNS
1926	1	12"		R	38
1926	2	12"		R	38
	1	9'-E	WPL		
	2	10'-W	E PL		

4/29/43 J.H.W
5/15/43 CEH

CITY OF ROANOKE—WATER DEP'T

VALVE DIAGRAM

HANOVER AVE. & 18TH. ST. N. W.

SEC. MAP 232

DATE

PAGE NO. N.W. 212