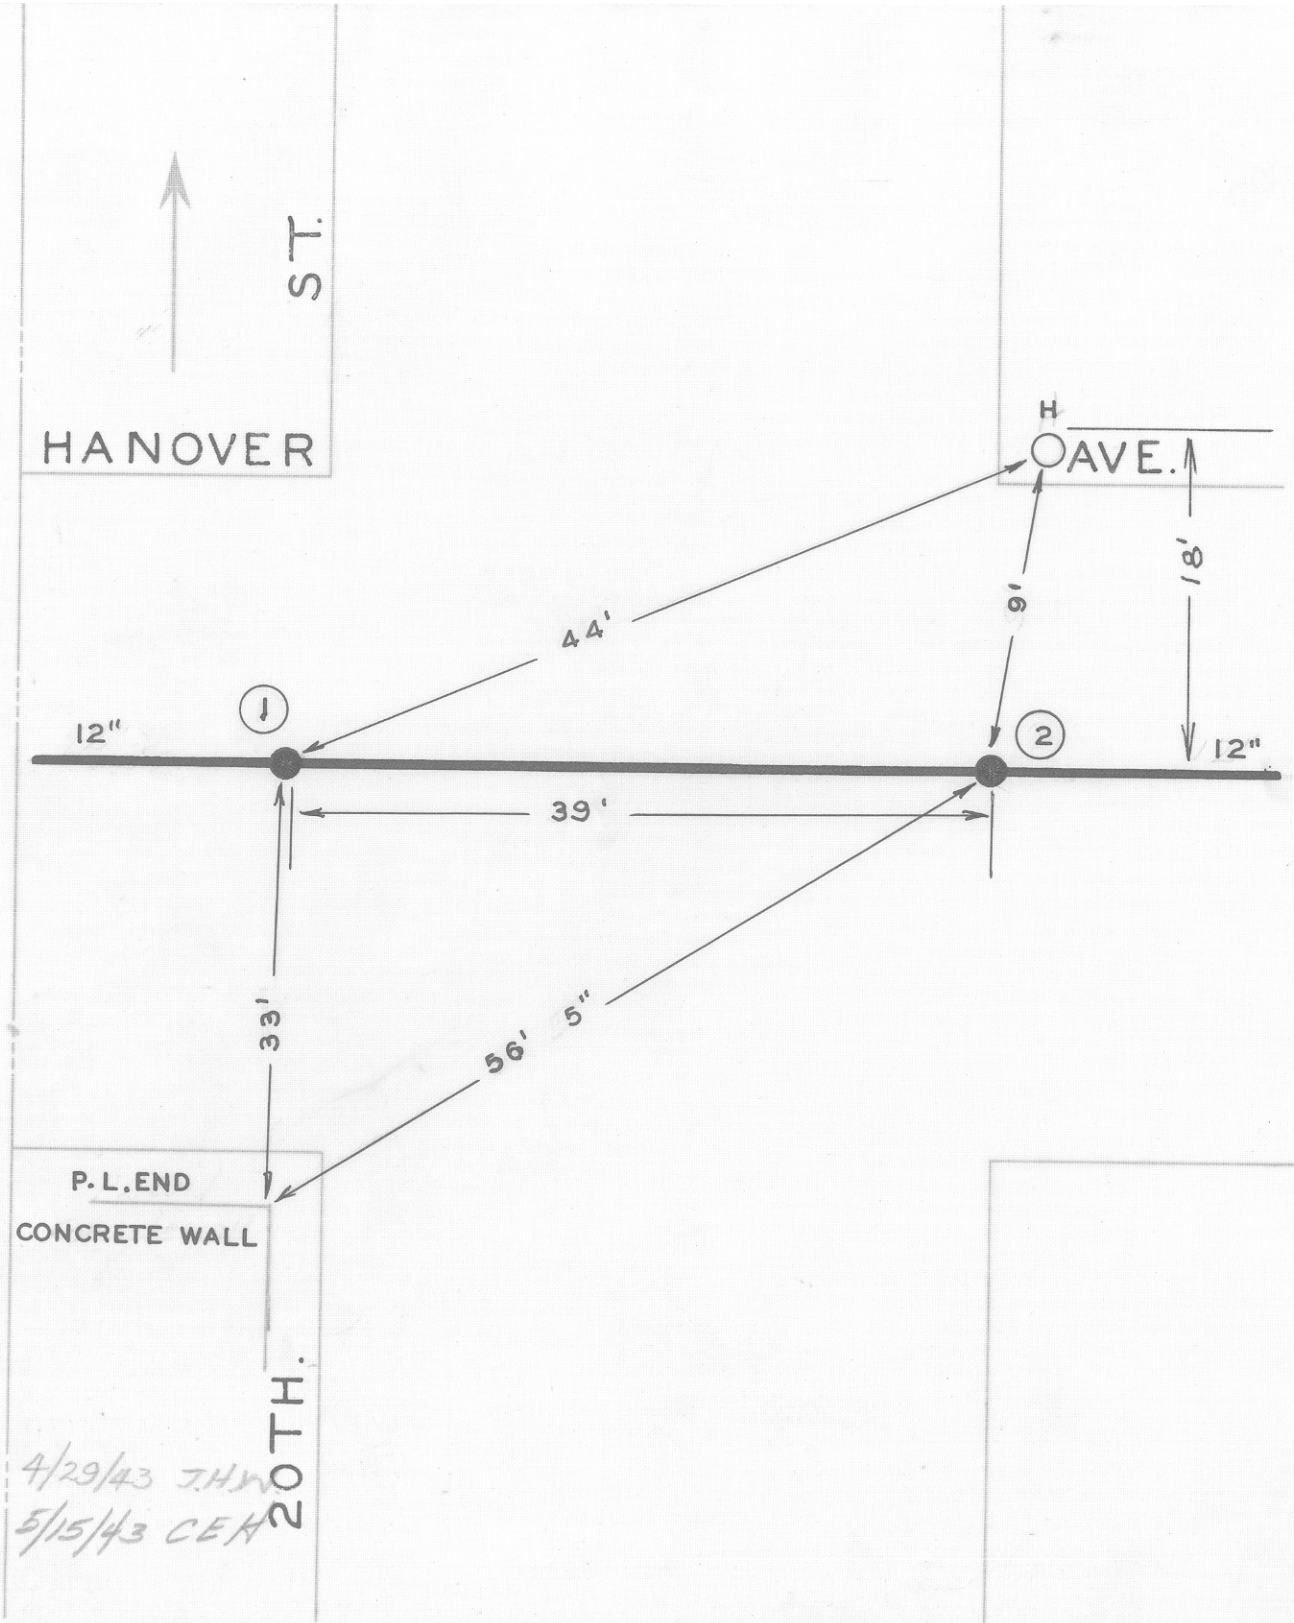

DATE	NO.	SIZE	MAKE	OPEN	TURNS
1926	1	12"		R	38
1926	2	12"		R	38
	1	9'-E	WPL		
	2	4'-W	EPL		

CITY OF ROANOKE—WATER DEP'T

VALVE DIAGRAM

HANOVER AVE. & 20TH. ST. N. W

SEC. MAP 232

DATE

PAGE NO. NW213