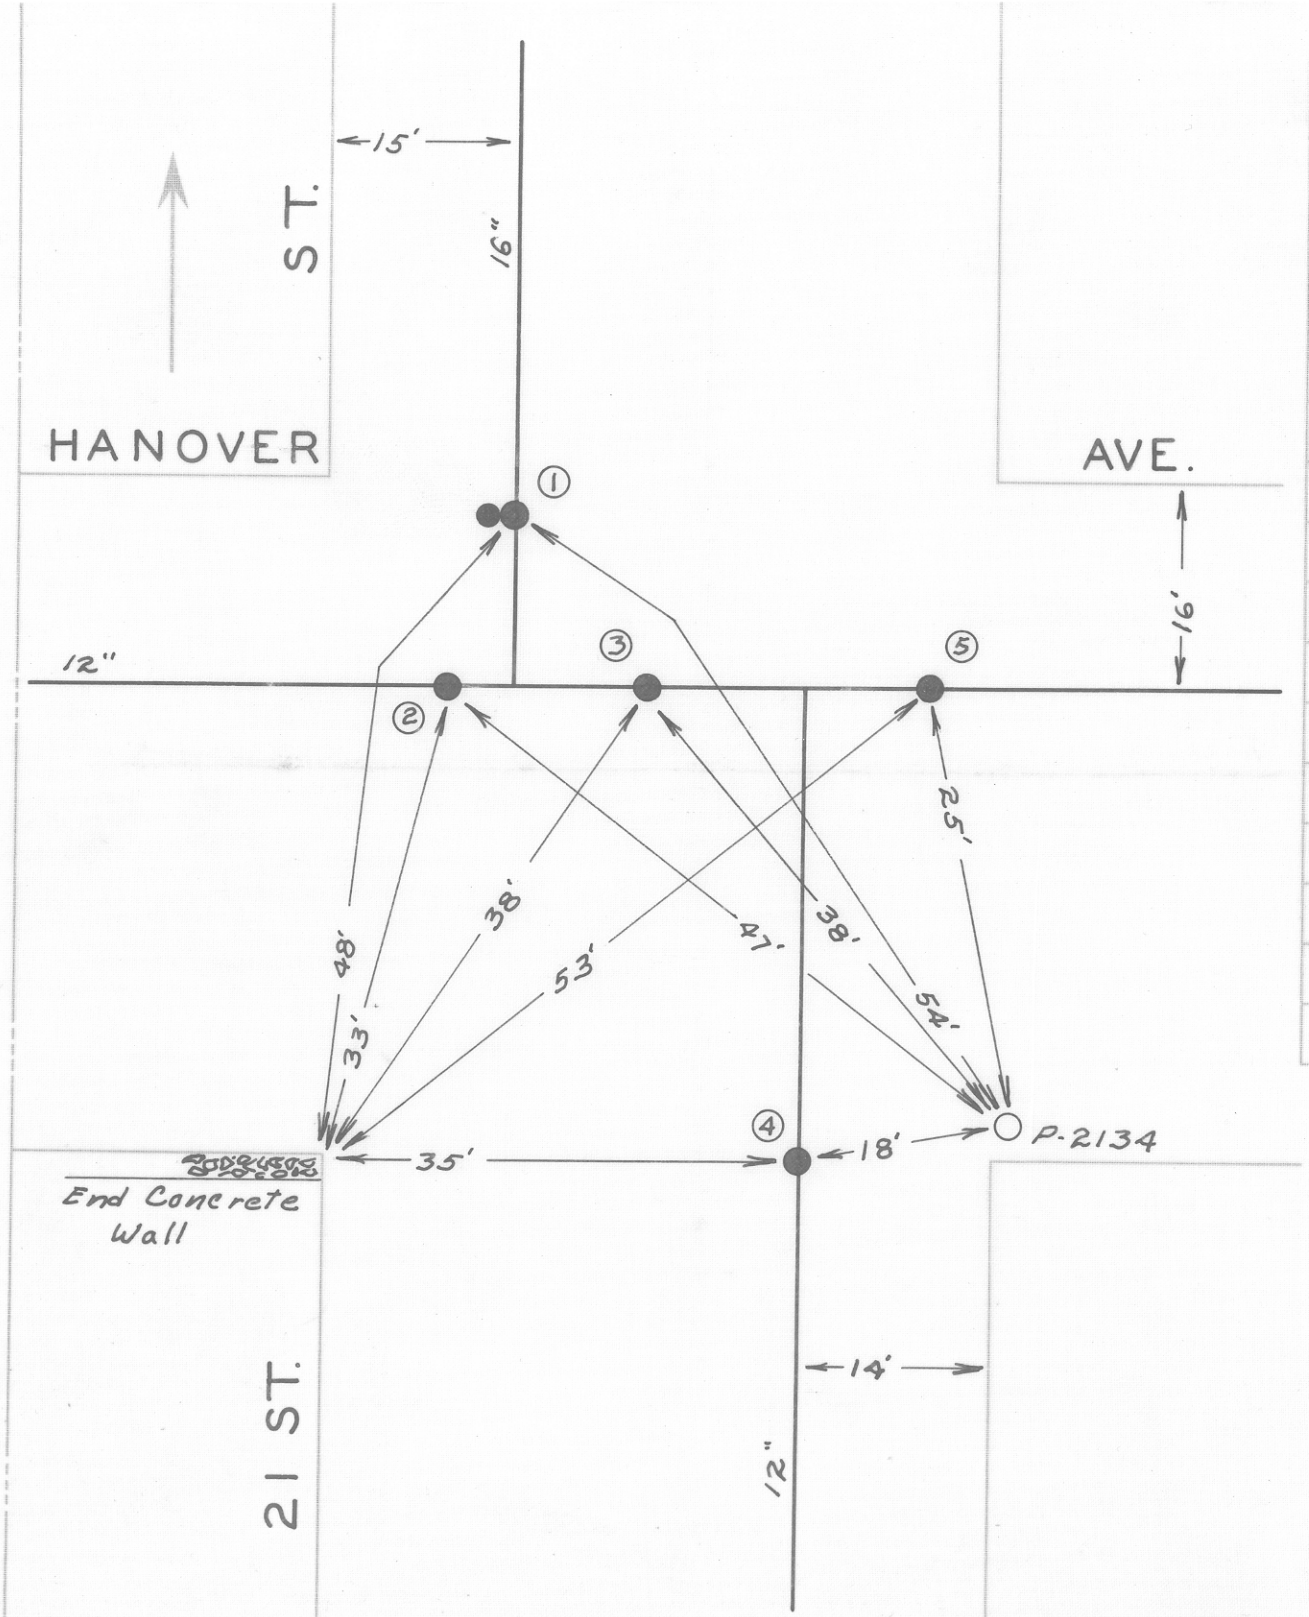

DATE	NO.	SIZE	MAKE	OPEN	TURNS
	1	16"	M+H	L	100
	2	12"	M+H	L	26
	3	12"	M+H	L	26
	4	12"			
	5	12"			
	1	3'-S	NPL		
	2	10'-E	WPL		
	3	26'-W	EPL		
	4	0	SPL		
	5	6'-W	EPL		

CITY OF ROANOKE—WATER DEP'T

VALVE DIAGRAM

HANOVER AVE. & 21ST. STREET N.W.

SEC. MAP 232

DATE PAGE NO.