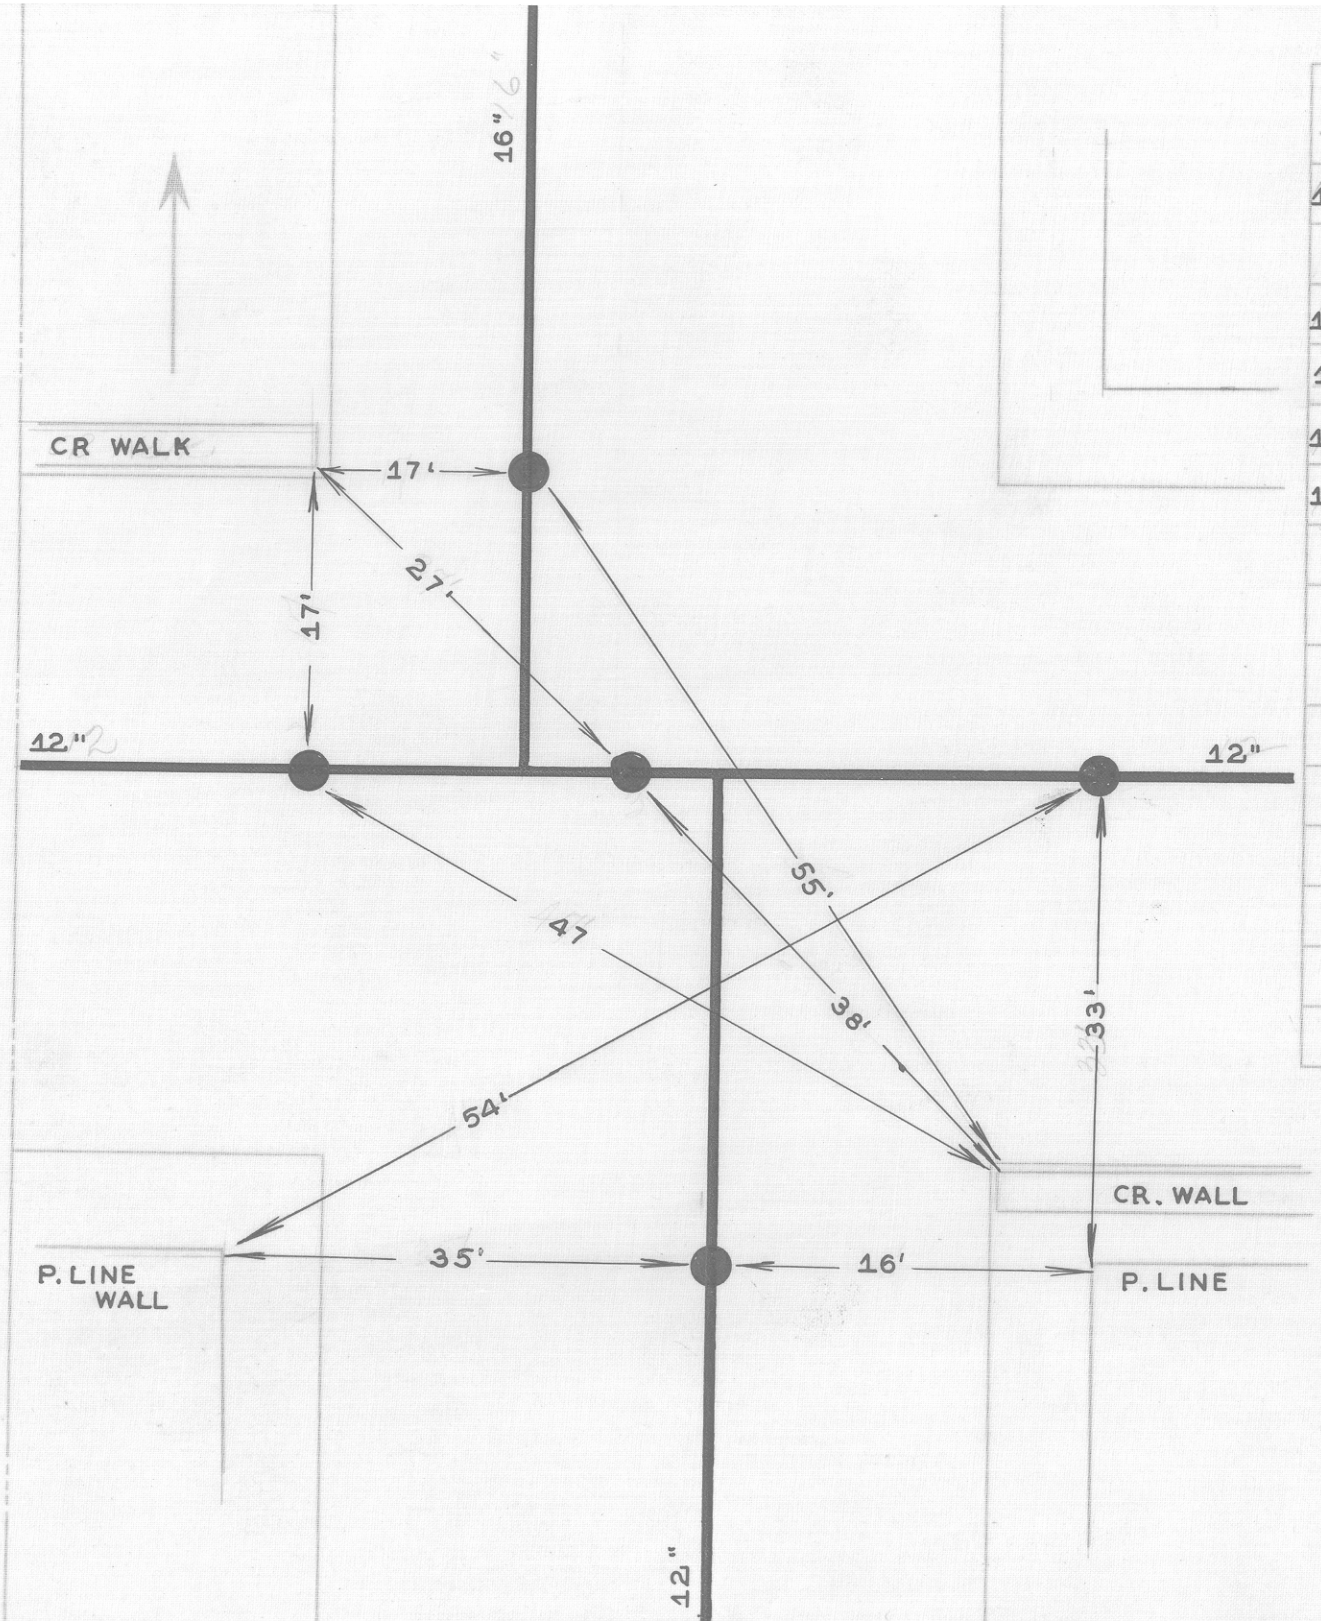

DATE	NO.	SIZE	MAKE	OPEN	TURNS
1946	1	16"	M. & H.	L	100
		3"	BY PAS	L	9
1946	2	12"	M. & H.	L	26
1946	3	12"	M. & H.	L	26
1951	4	12"	DARLING	R	39
1951	5	12"	DARLING	R	39

CITY OF ROANOKE—WATER DEP'T

VALVE DIAGRAM

HANOVER AVENUE &

21ST STREET N.W

SEC. MAP 232

DATE

PAGE NO. NW310.