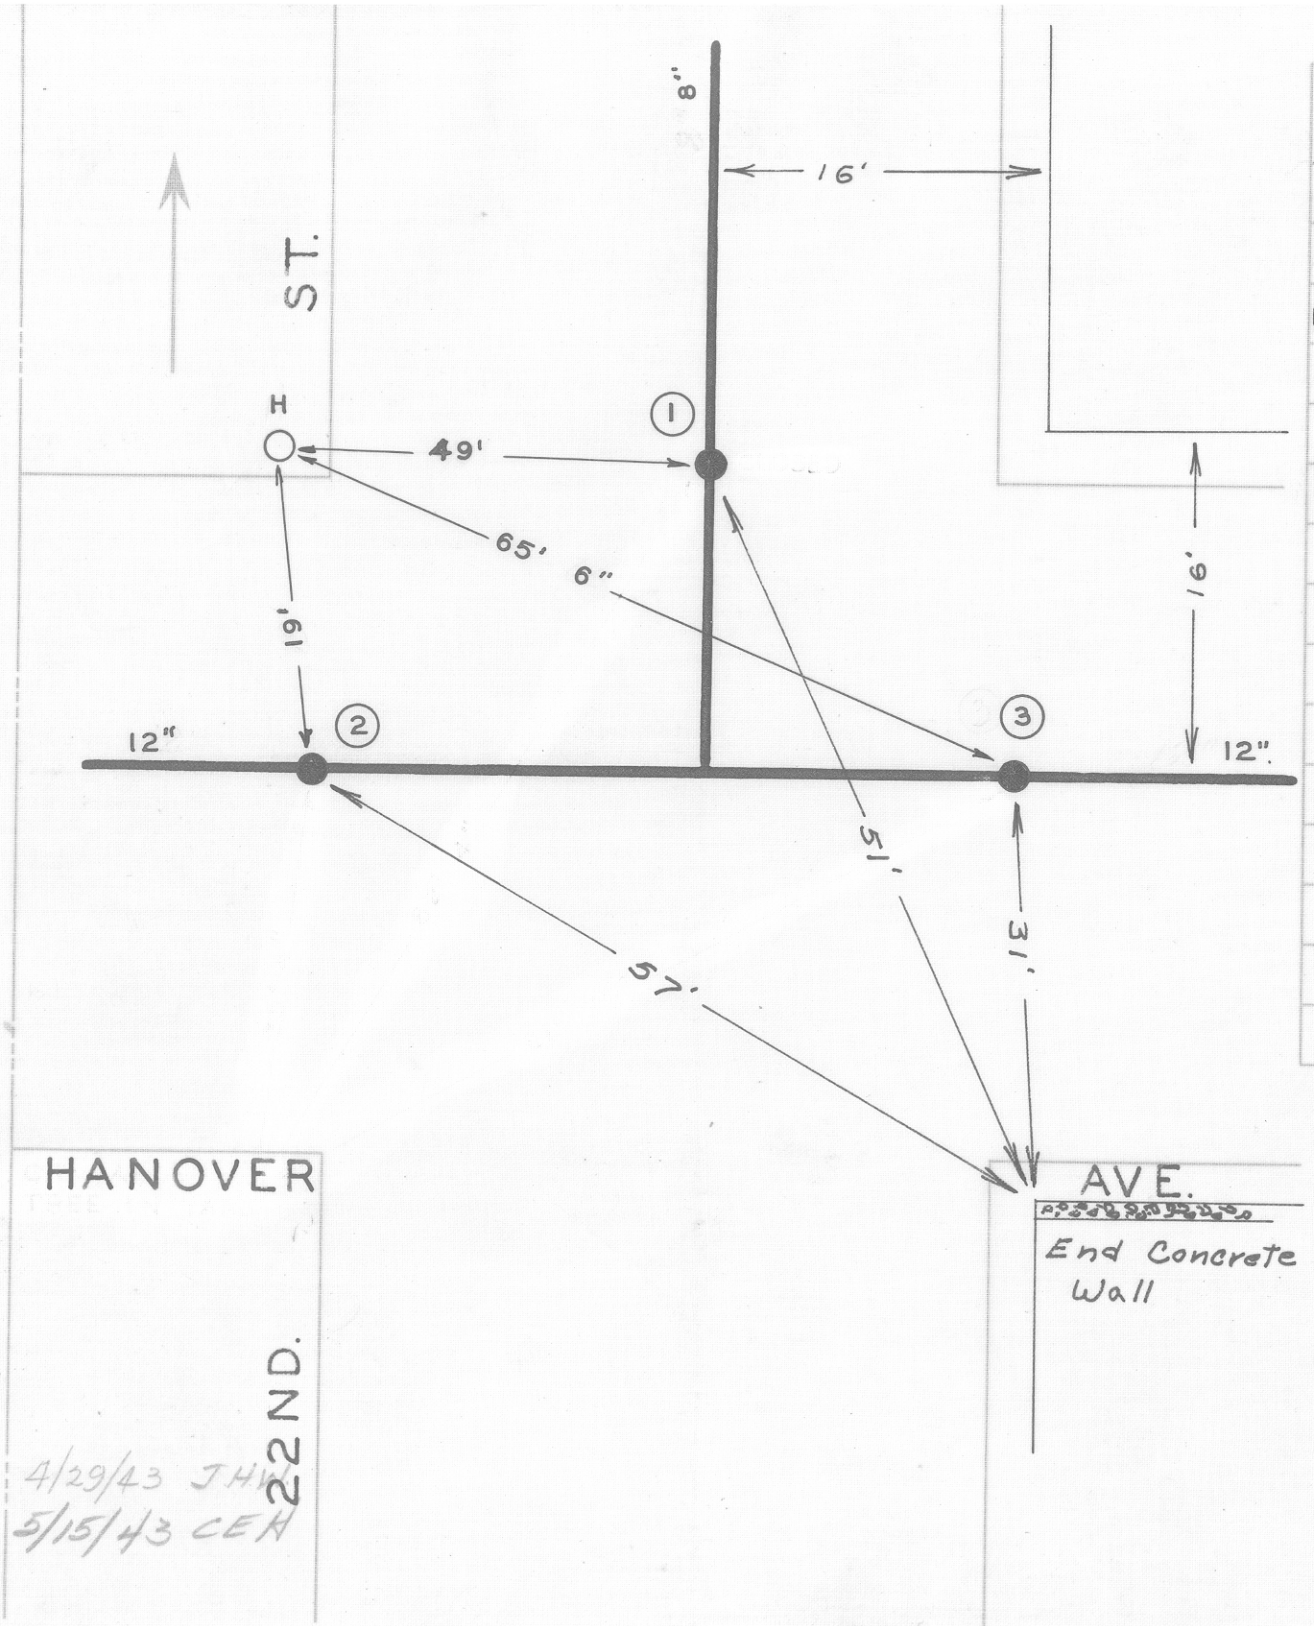

DATE	NO.	SIZE	MAKE	OPEN	TURNS
1940	1	8"		R	27
1926	2	12"		R	39
1926	3	12"		R	38
	1	0	NPL		
	2	0	WPL		
	3	0	EPL		

CITY OF ROANOKE—WATER DEP'T

VALVE DIAGRAM

HANOVER AVE. & 22ND. ST. N.W.

SEC. MAP 232

DATE

PAGE NO. NW.214