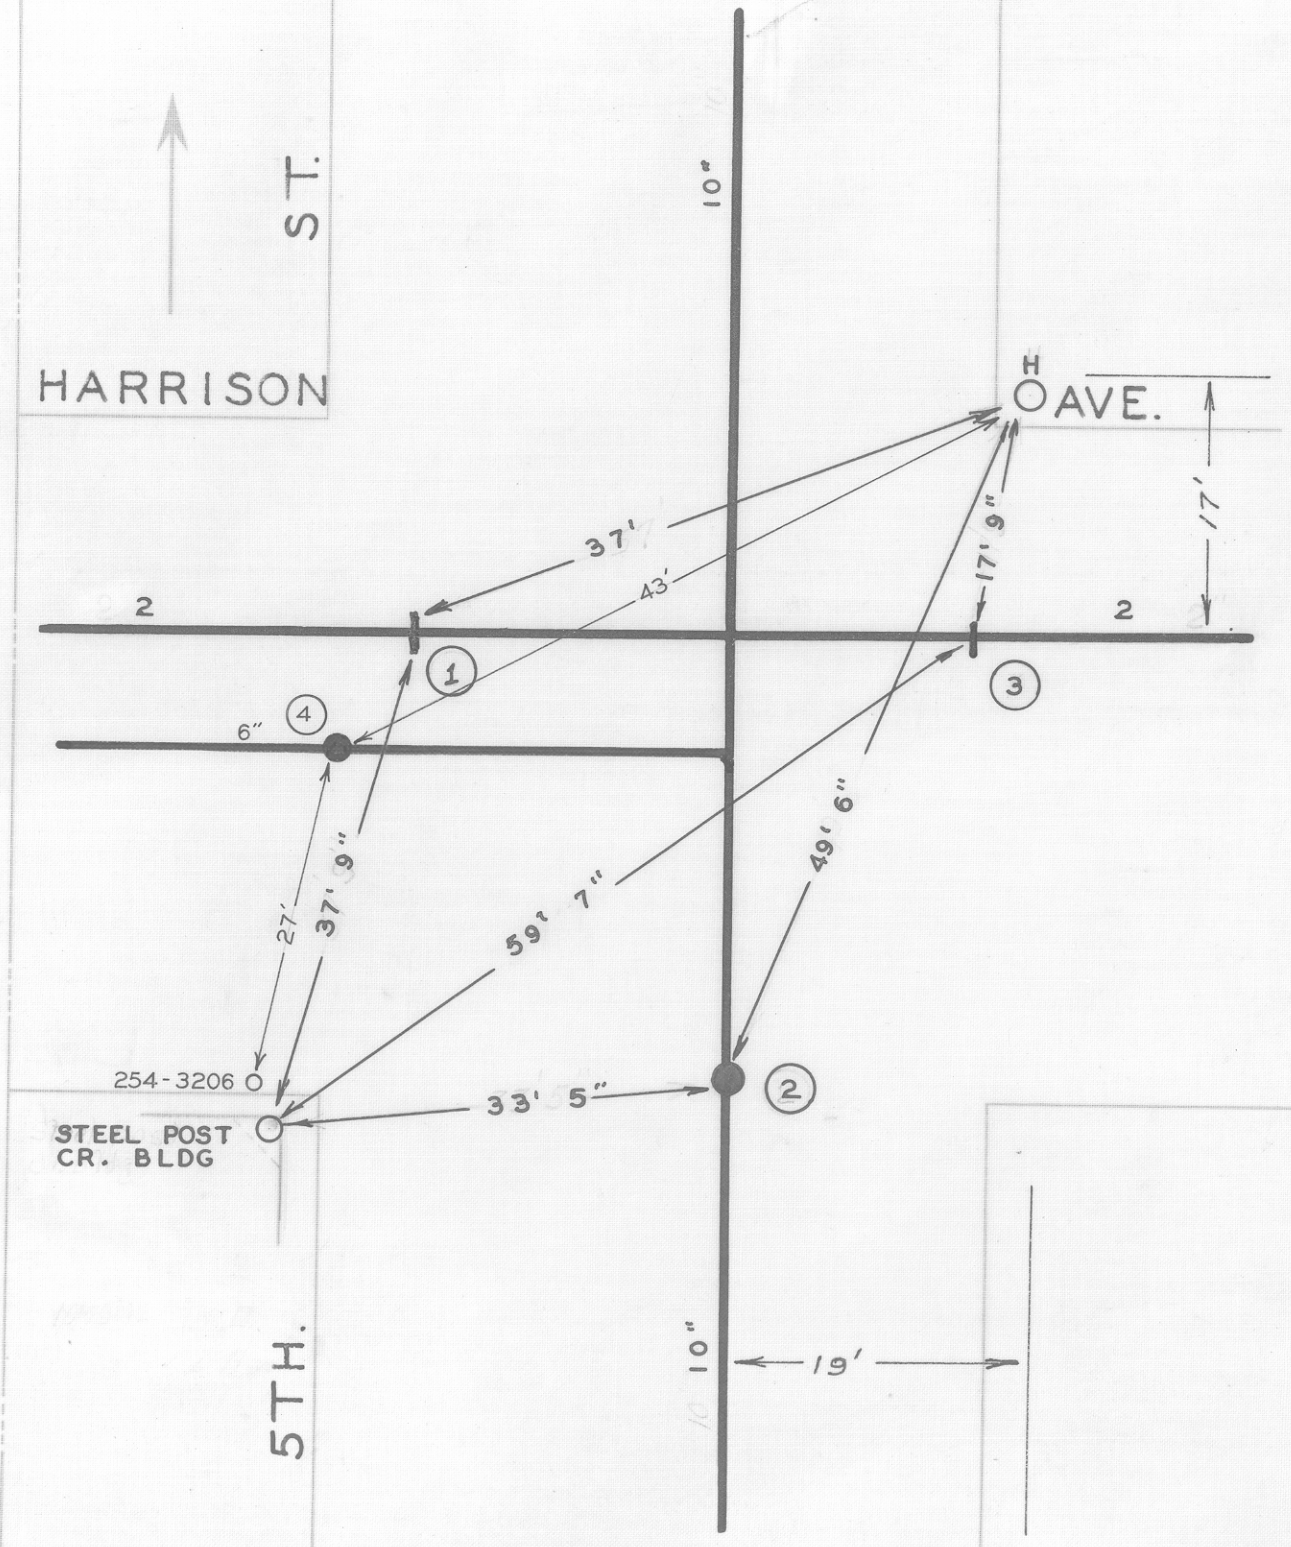

DATE	NO.	SIZE	MAKE	OPEN	TURNS
1893	1	2"		R	7
1893	2	10"		R	35
1893	3	2"		R	7
11-73	4	6"	MUELLER	R	
	1	8'-E	WPL		
	2	4'-N	SPL		
	3	11'-W	EPL		

CITY OF ROANOKE—WATER DEP'T

VALVE DIAGRAM

HARRISON AVE. & 5TH. ST N W

SEC. MAP 201

DATE

PAGE NO. NW. 34