DATE	NO.	SIZE	MAKE	OPEN	TURNS
1906	1	2"		L	4
	1	0	SPL		

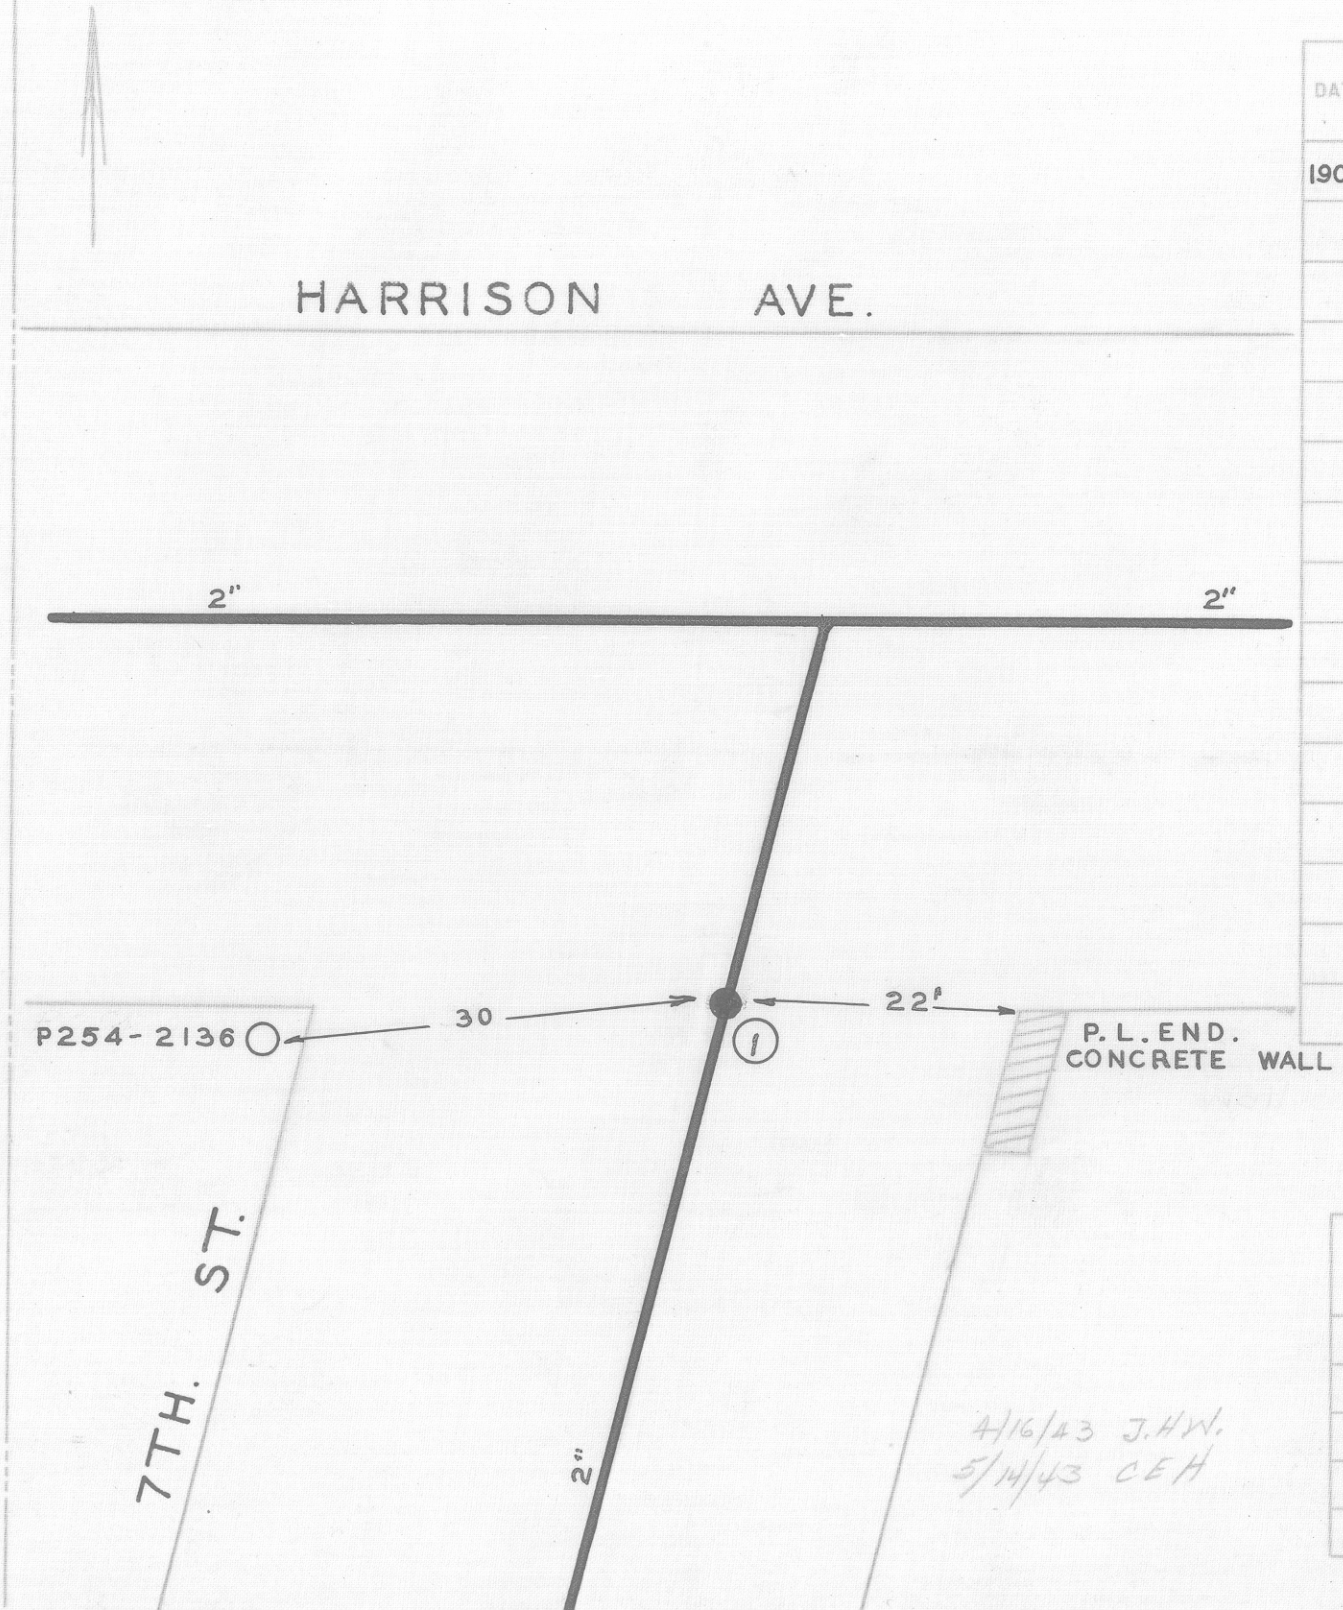

CITY OF ROANOKE—WATER DEP'T

VALVE DIAGRAM

HARRISON AVE. & 7TH. ST. N. W.

SEC. MAP 211

DATE

PAGE NO. NW.102