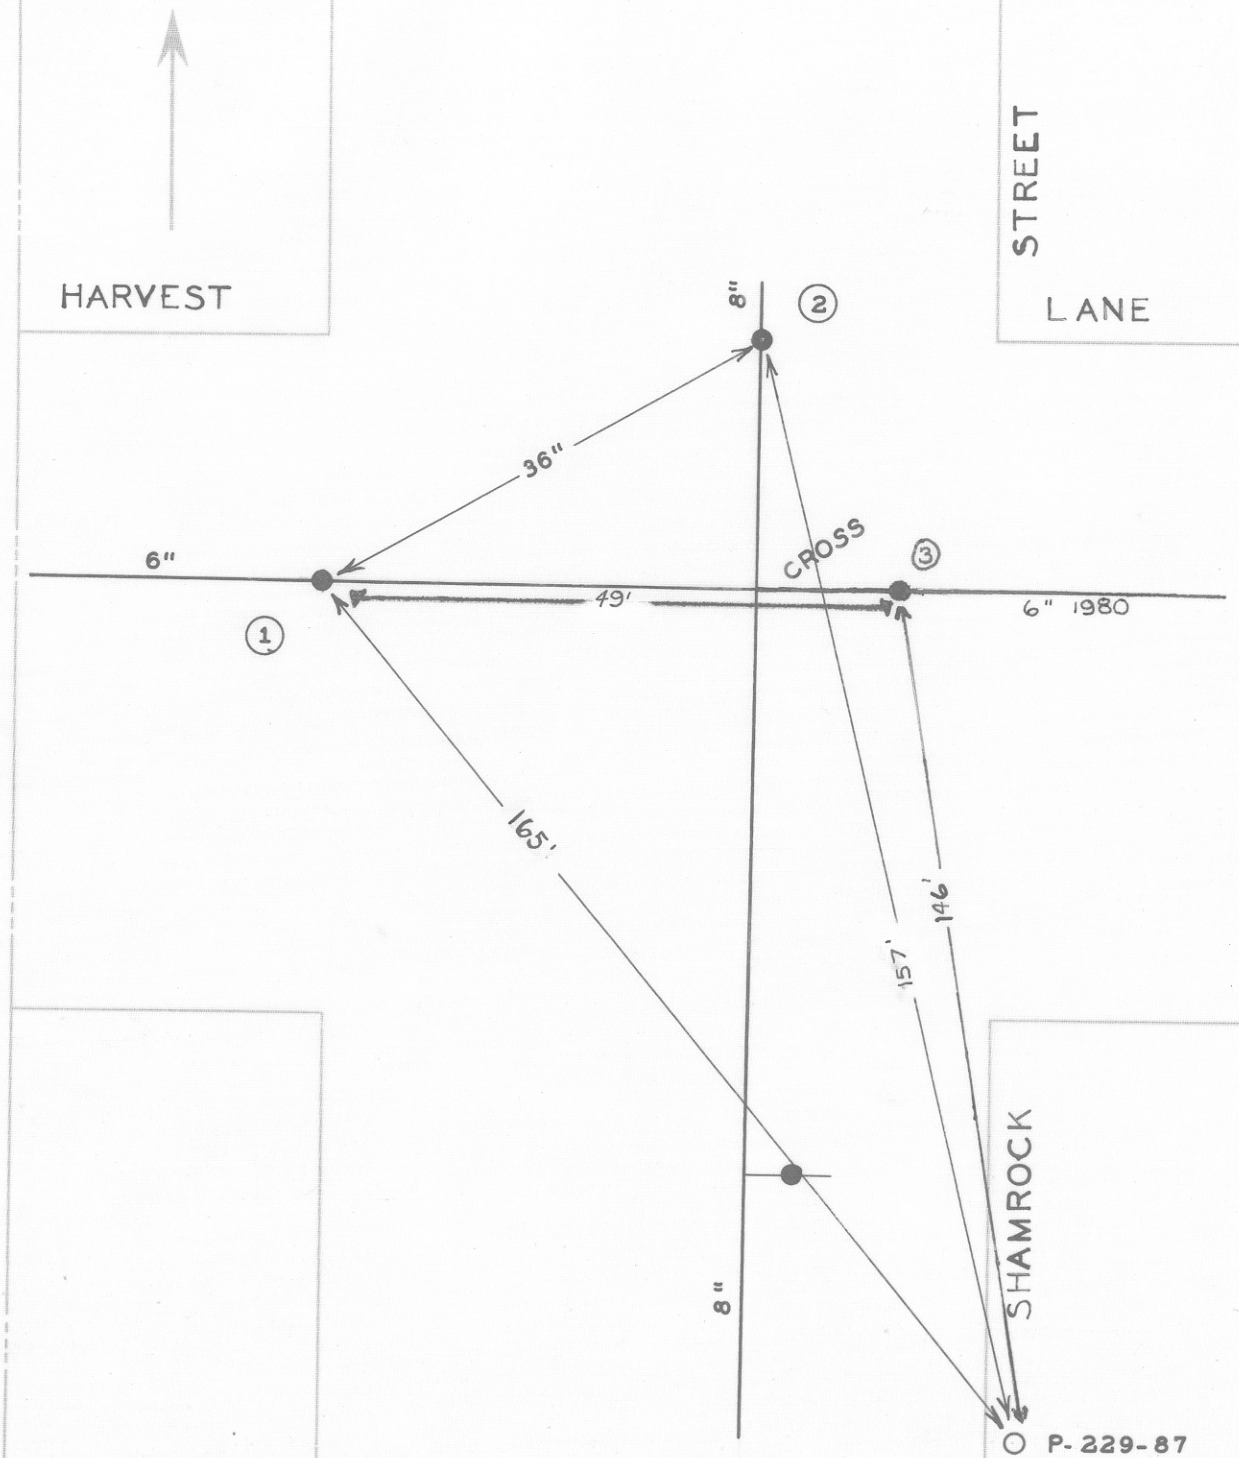

DATE	NO.	SIZE	MAKE	OPEN	TURNS
7-60	1	6"	DARLING	R	20
7-60	2	8"	DARLING	R	20
8-80	3	6"	MUELLER	R	
	1	0'	W.P.L.		
	2	0'	N.P.L.		
	3	17'	N.P.L.		

639

CITY OF ROANOKE — WATER DEP'T

VALVE DIAGRAM

HARVEST LANE &

SHAMROCK STREET N.W.

SEC. MAP 5

DATE PAGE NO.