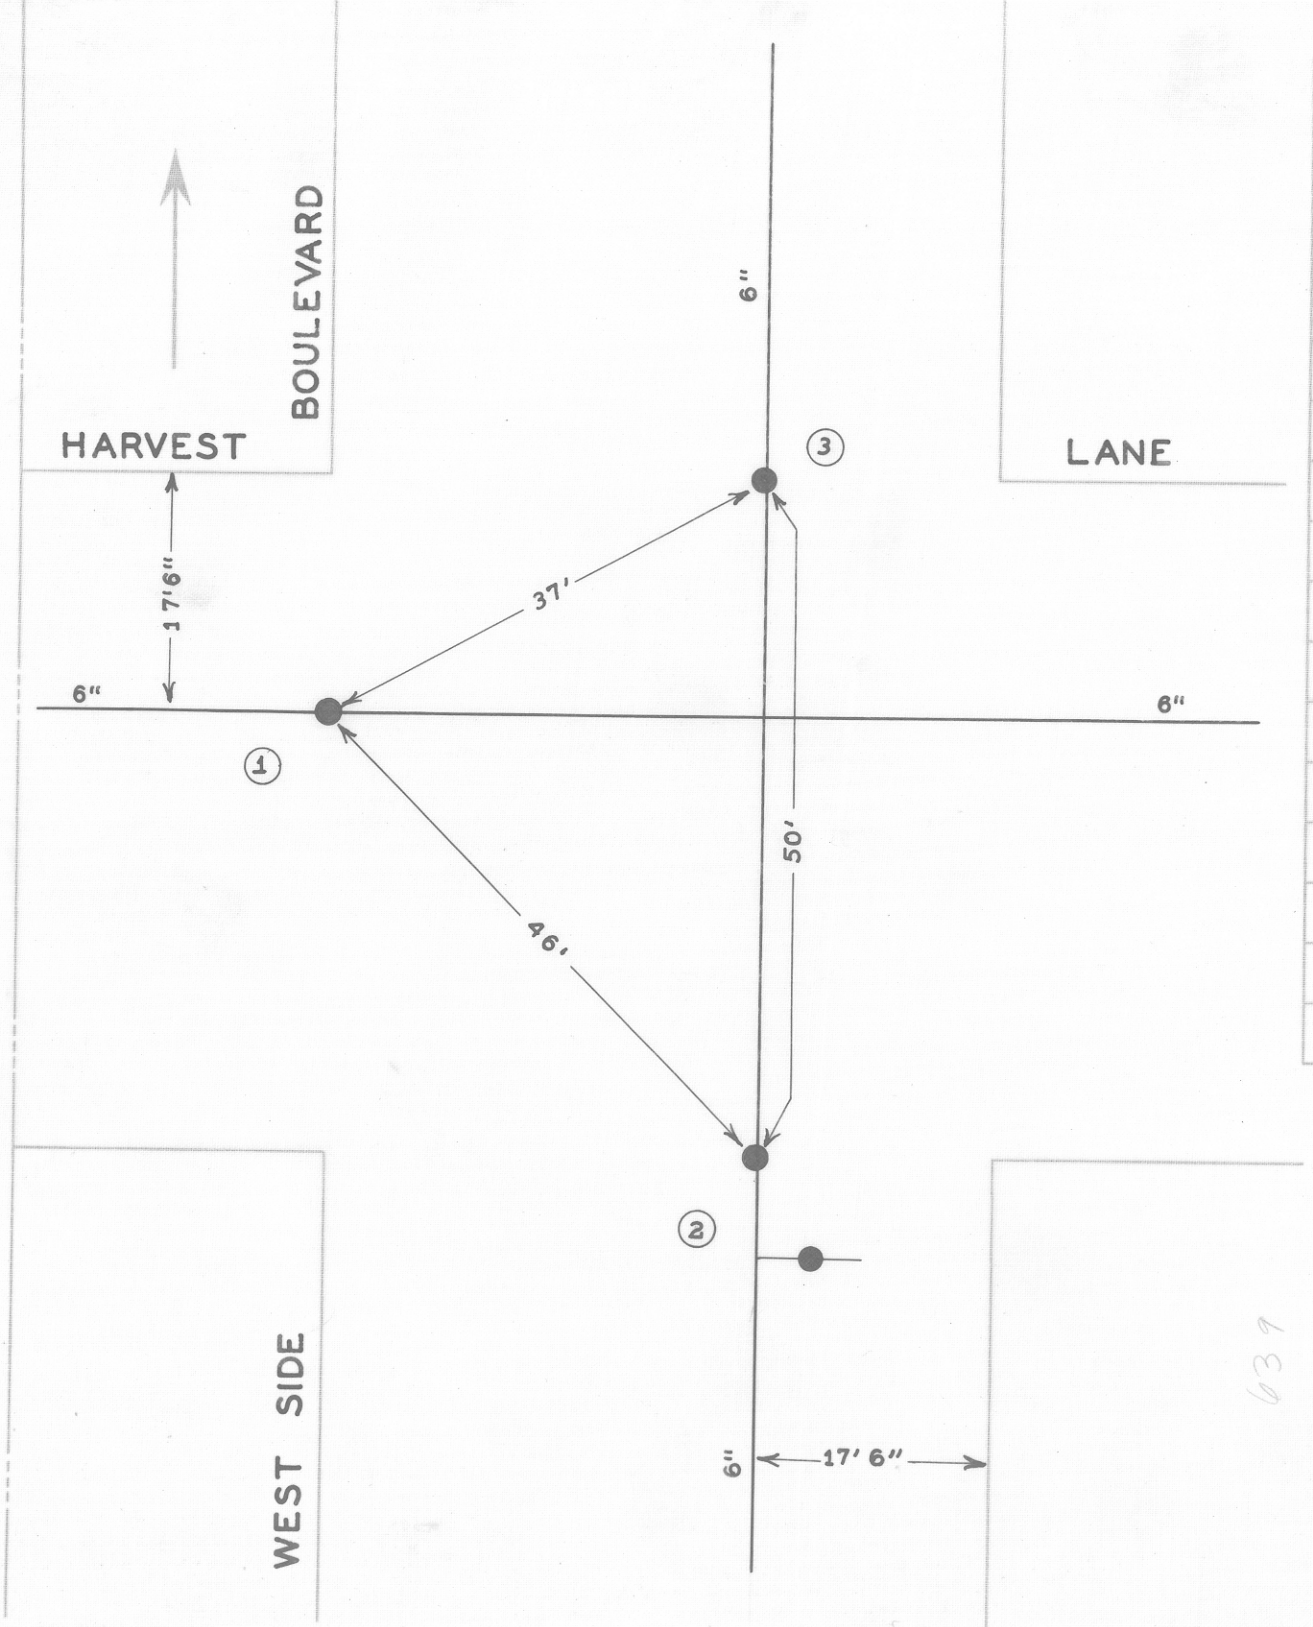

DATE	NO.	SIZE	MAKE	OPEN	TURNS
7-60	1	6"	DARLING	R	20
7-60	2	6"	DARLING	R	20
7-60	3	6"	DARLING	R	20
	1	0	W.P.L.		
	2	0	S.P.L.		
	3	0	N.P.L.		

639

CITY OF ROANOKE—WATER DEP'T

VALVE DIAGRAM

HARVEST LANE &

WEST SIDE BOULEVARD

N.W.

SEC. MAP 5

DATE PAGE NO.