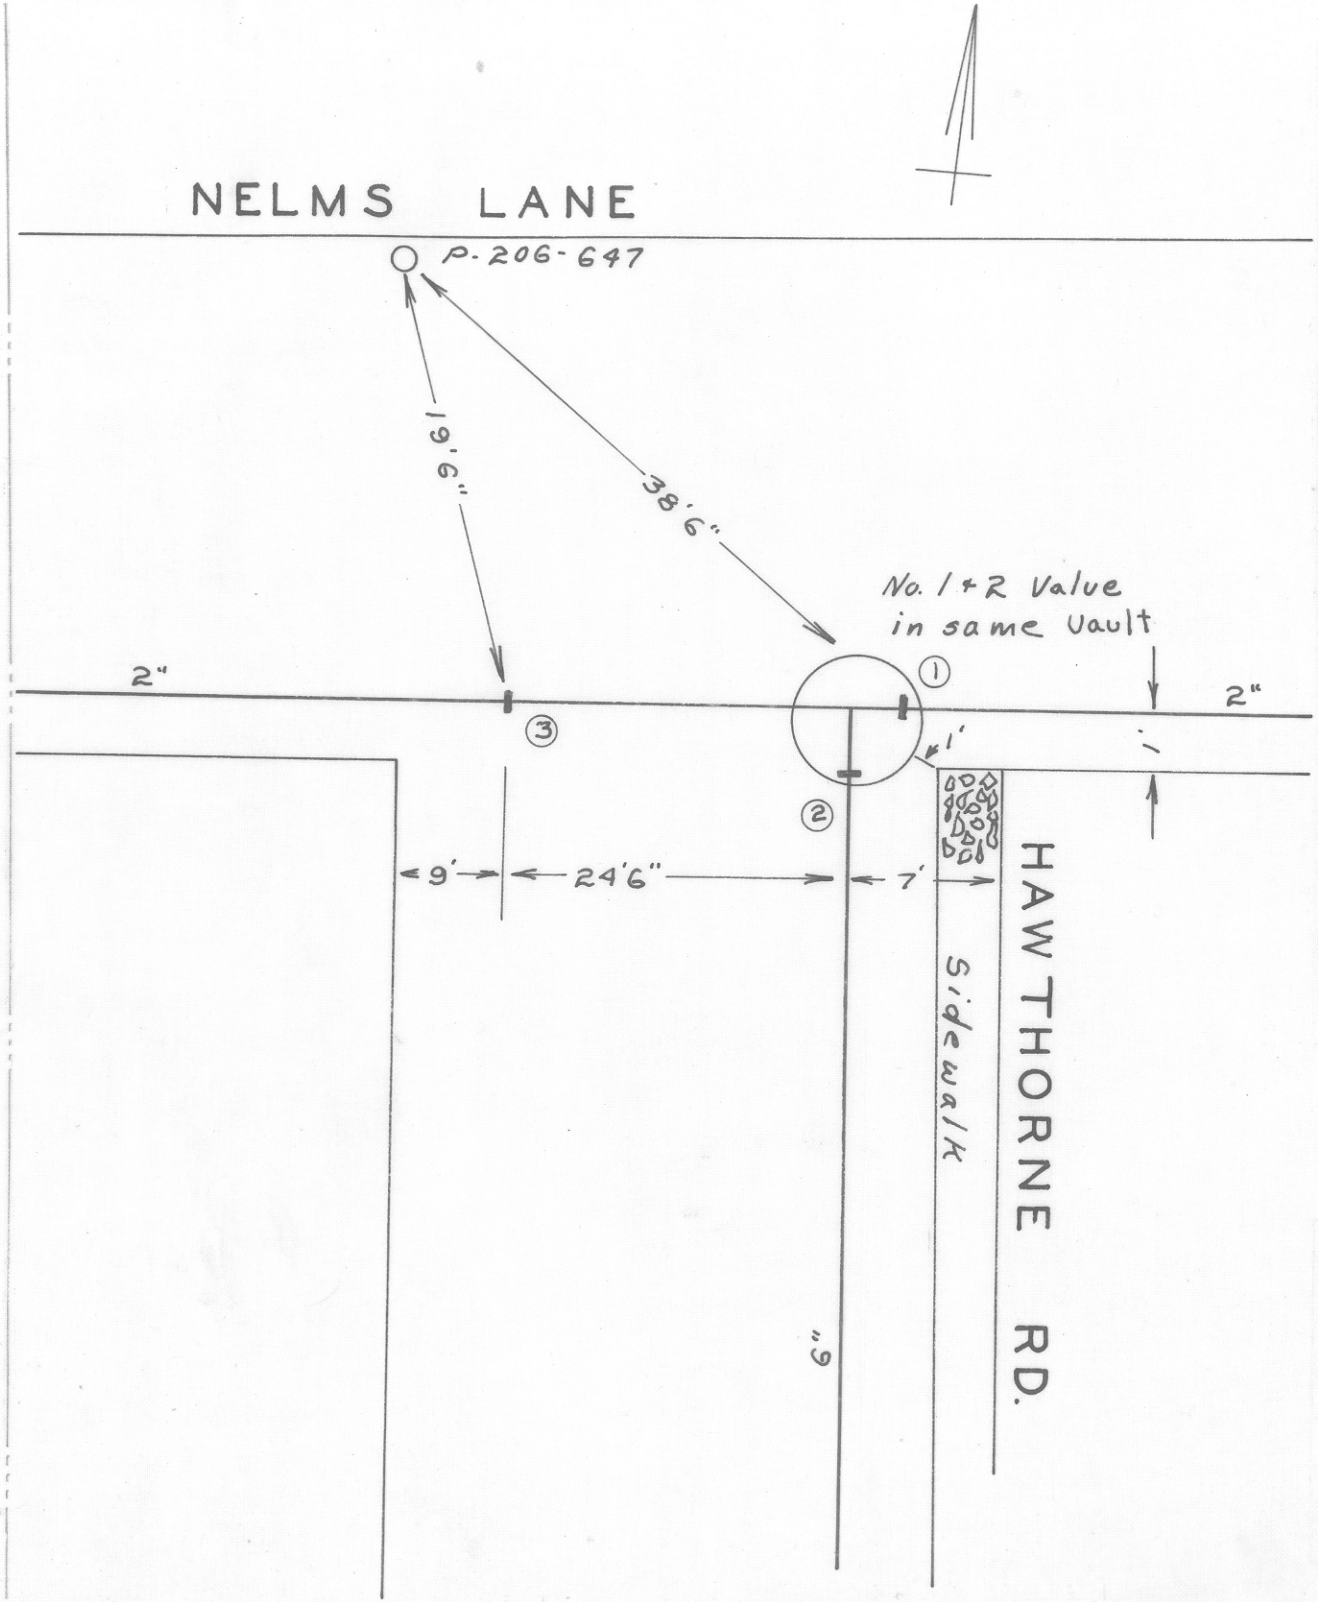

DATE	NO.	SIZE	MAKE	OPEN	TURNS
	1	2"			
	2	2"	Powell	R	
	3	2"	Powell	R	
	1	6'-S	NPL		
	2	7'-W	EPL		
	3	9'-E	WPL		

CITY OF ROANOKE—WATER DEPT.

VALVE DIAGRAM

HAWTHORN RD. &

NELMS LANE N. W.

SEC. MAP 219

DATE PAGE NO.

"IMPERIAL" TRACING CLOTH
K & E CO., N. Y.