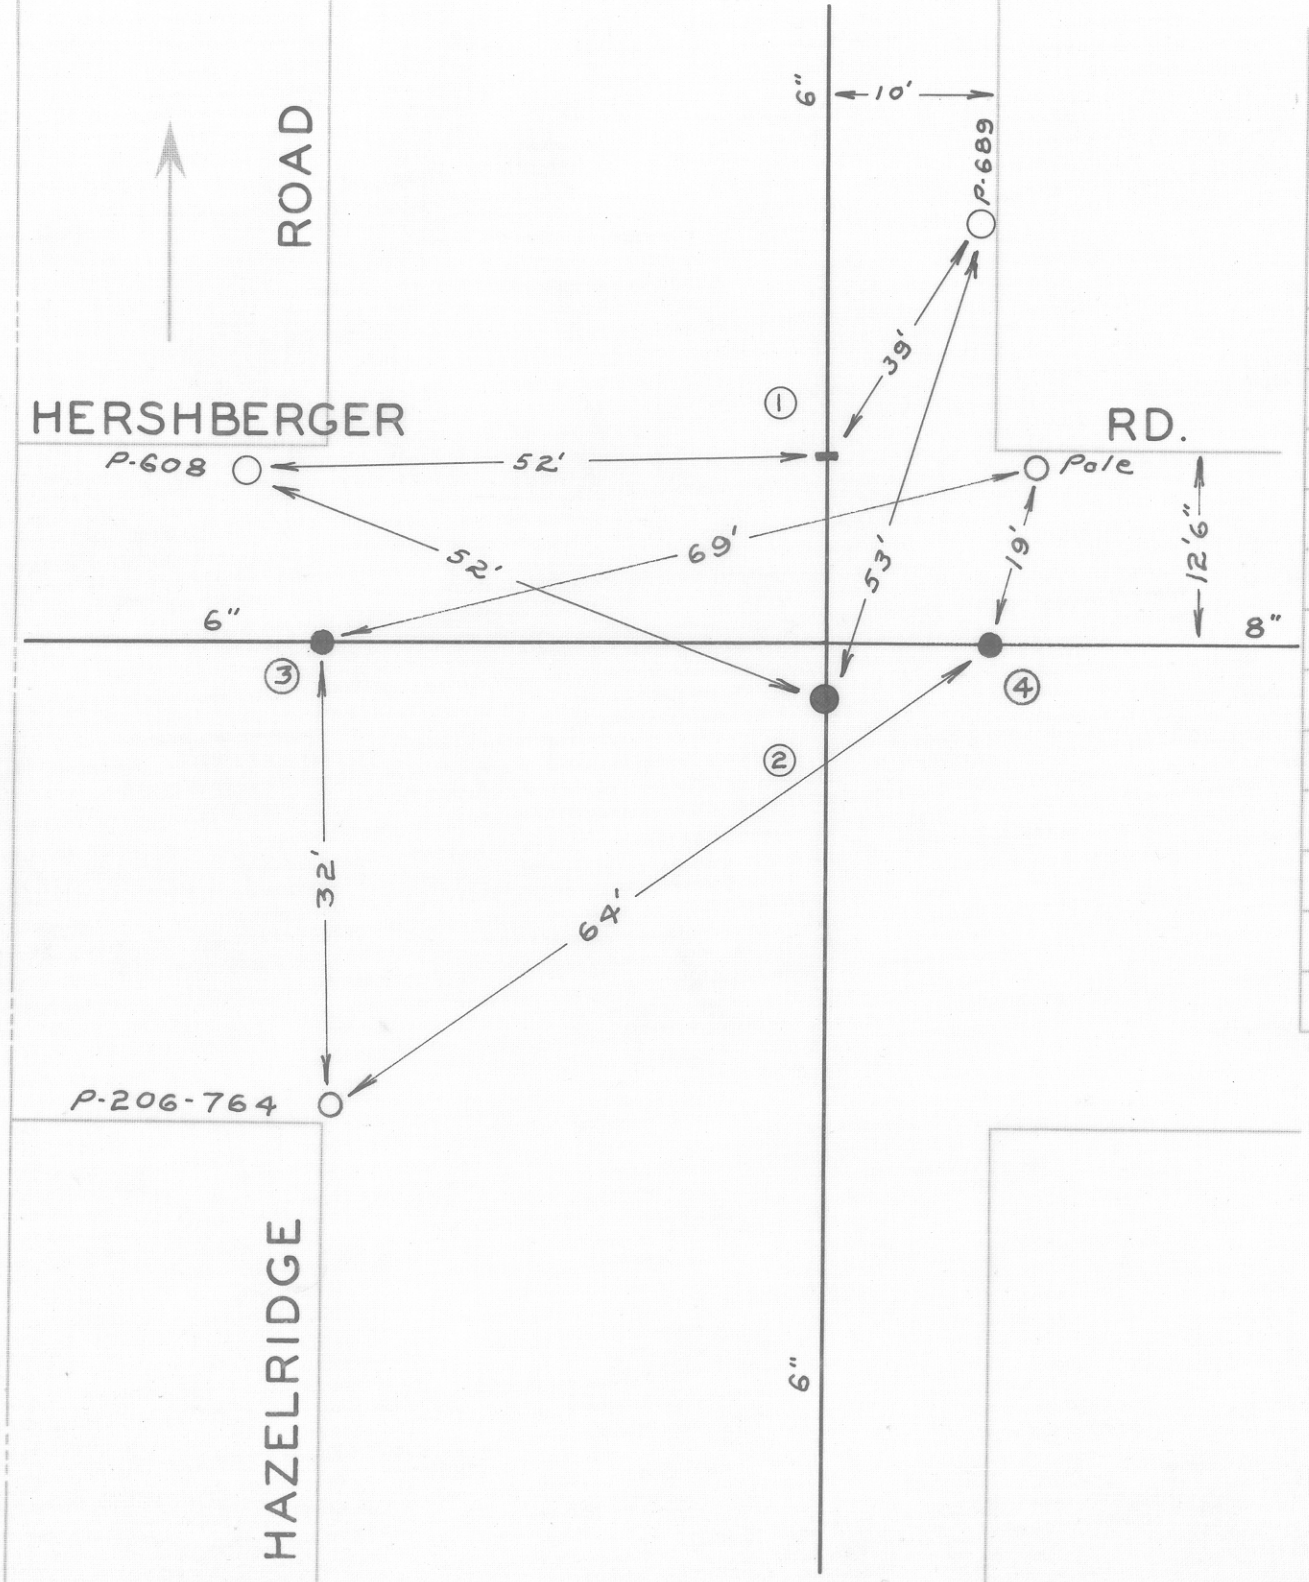

DATE	NO.	SIZE	MAKE	OPEN	TURNS
	1	6"			
	2	6"			
'57	3	6"	MUELLER	R	
'57	4	8"	MUELLER	R	
	1	0	NPL		
	2	33'-N	SPL		
	3	0	WPL		
	4	0	EPL		

CITY OF ROANOKE—WATER DEP'T

VALVE DIAGRAM

HAZELRIDGE RD. &

HERSHBERGER RD. N. W.

SEC. MAP 220

DATE PAGE NO.