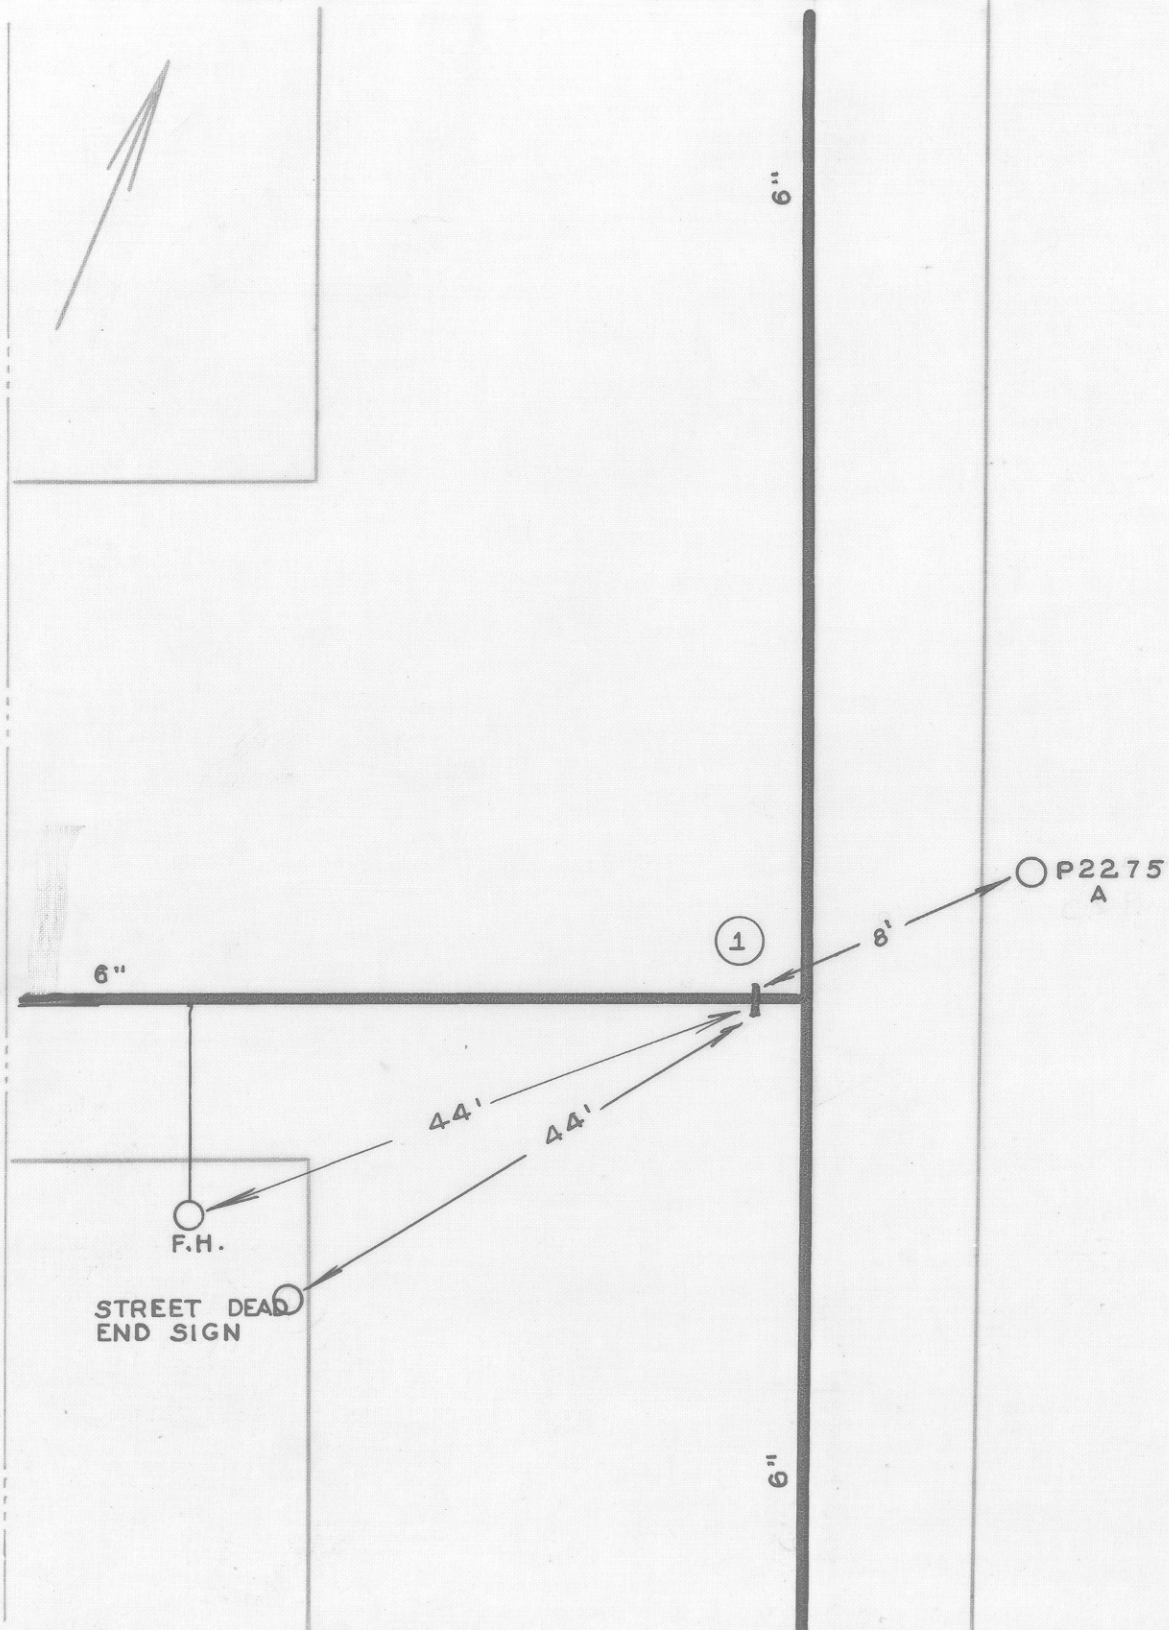

DATE	NO.	SIZE	MAKE	OPEN	TURNS
	1	6"			

CITY OF ROANOKE — WATER DEPT.

VALVE DIAGRAM

HAZELRIDGE ROAD &

OAKLAWN AVENUE N W

SEC. MAP 218

DATE W R PAGE NO. NW438

"IMPERIAL" TRACING CLOTH
K & E CO., N. Y.