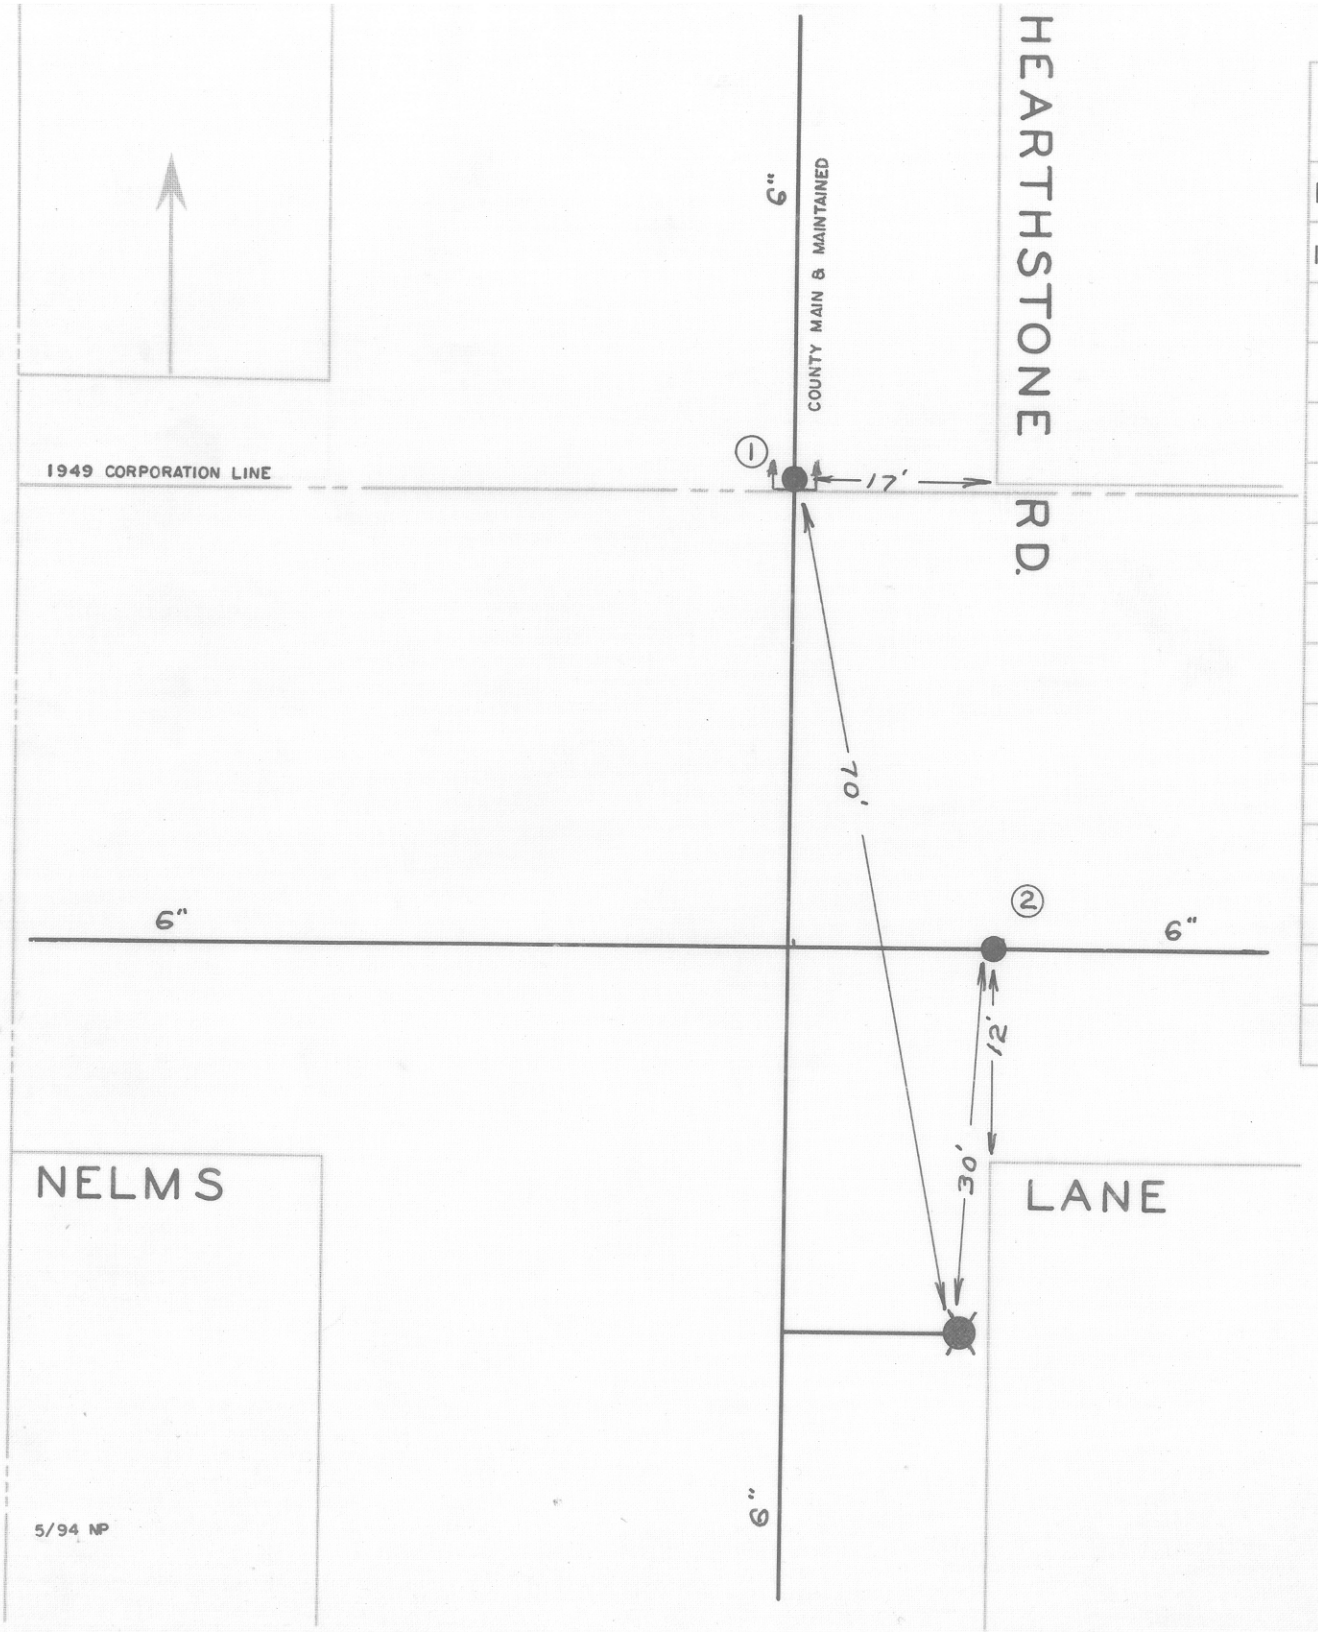

DATE	NO.	SIZE	MAKE	OPEN	TURNS
1955	1	6"	MUELLER	R	21
1955	2	6"	MUELLER	R	21
	1	0	NPL		
	2	0	EPL		

CITY OF ROANOKE—WATER DEP'T

VALVE DIAGRAM

HEARTHSTONE RD. &

NELMS LANE N. W.

SEC. MAP 219

DATE PAGE NO.