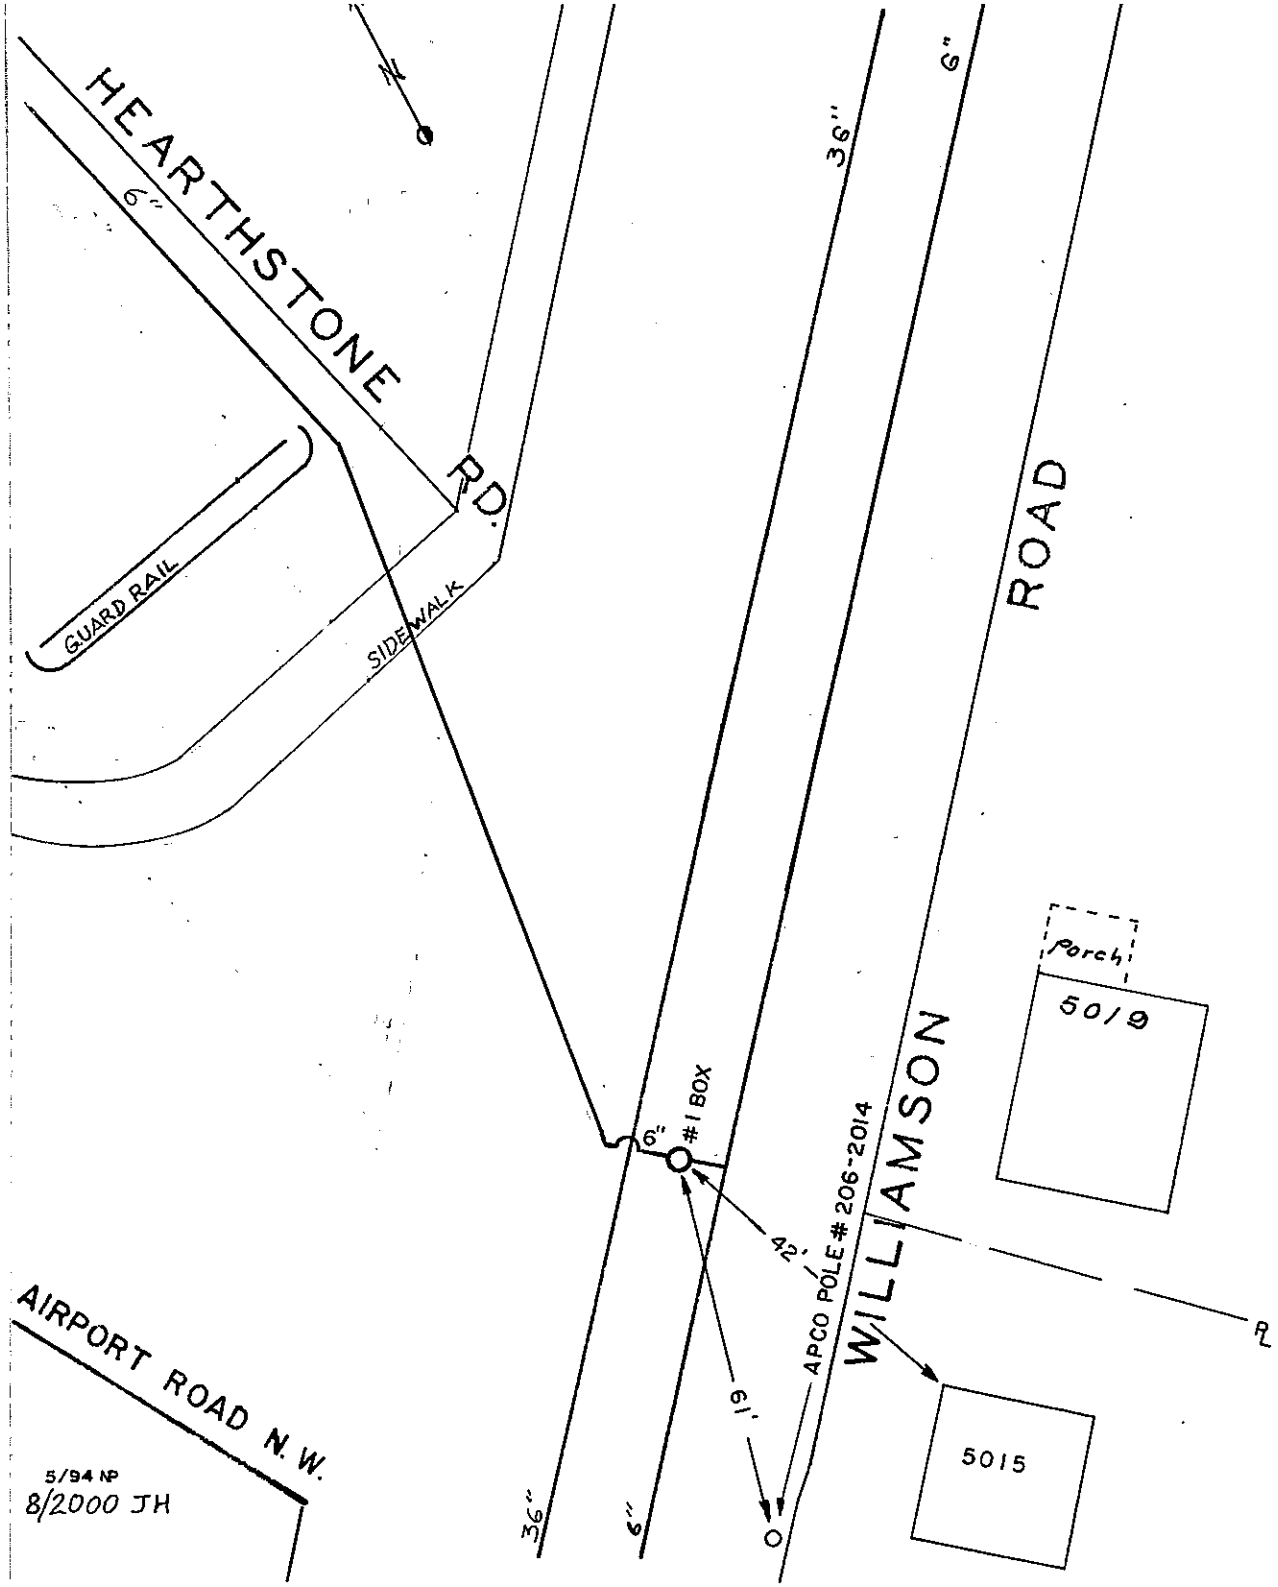

DATE	NO.	SIZE	MAKE	OPEN	TWONG
1993	1	6"	MUELLER	R	

HEARTHSTONE RD. &
WILLIAMSON RD. N.W.

219