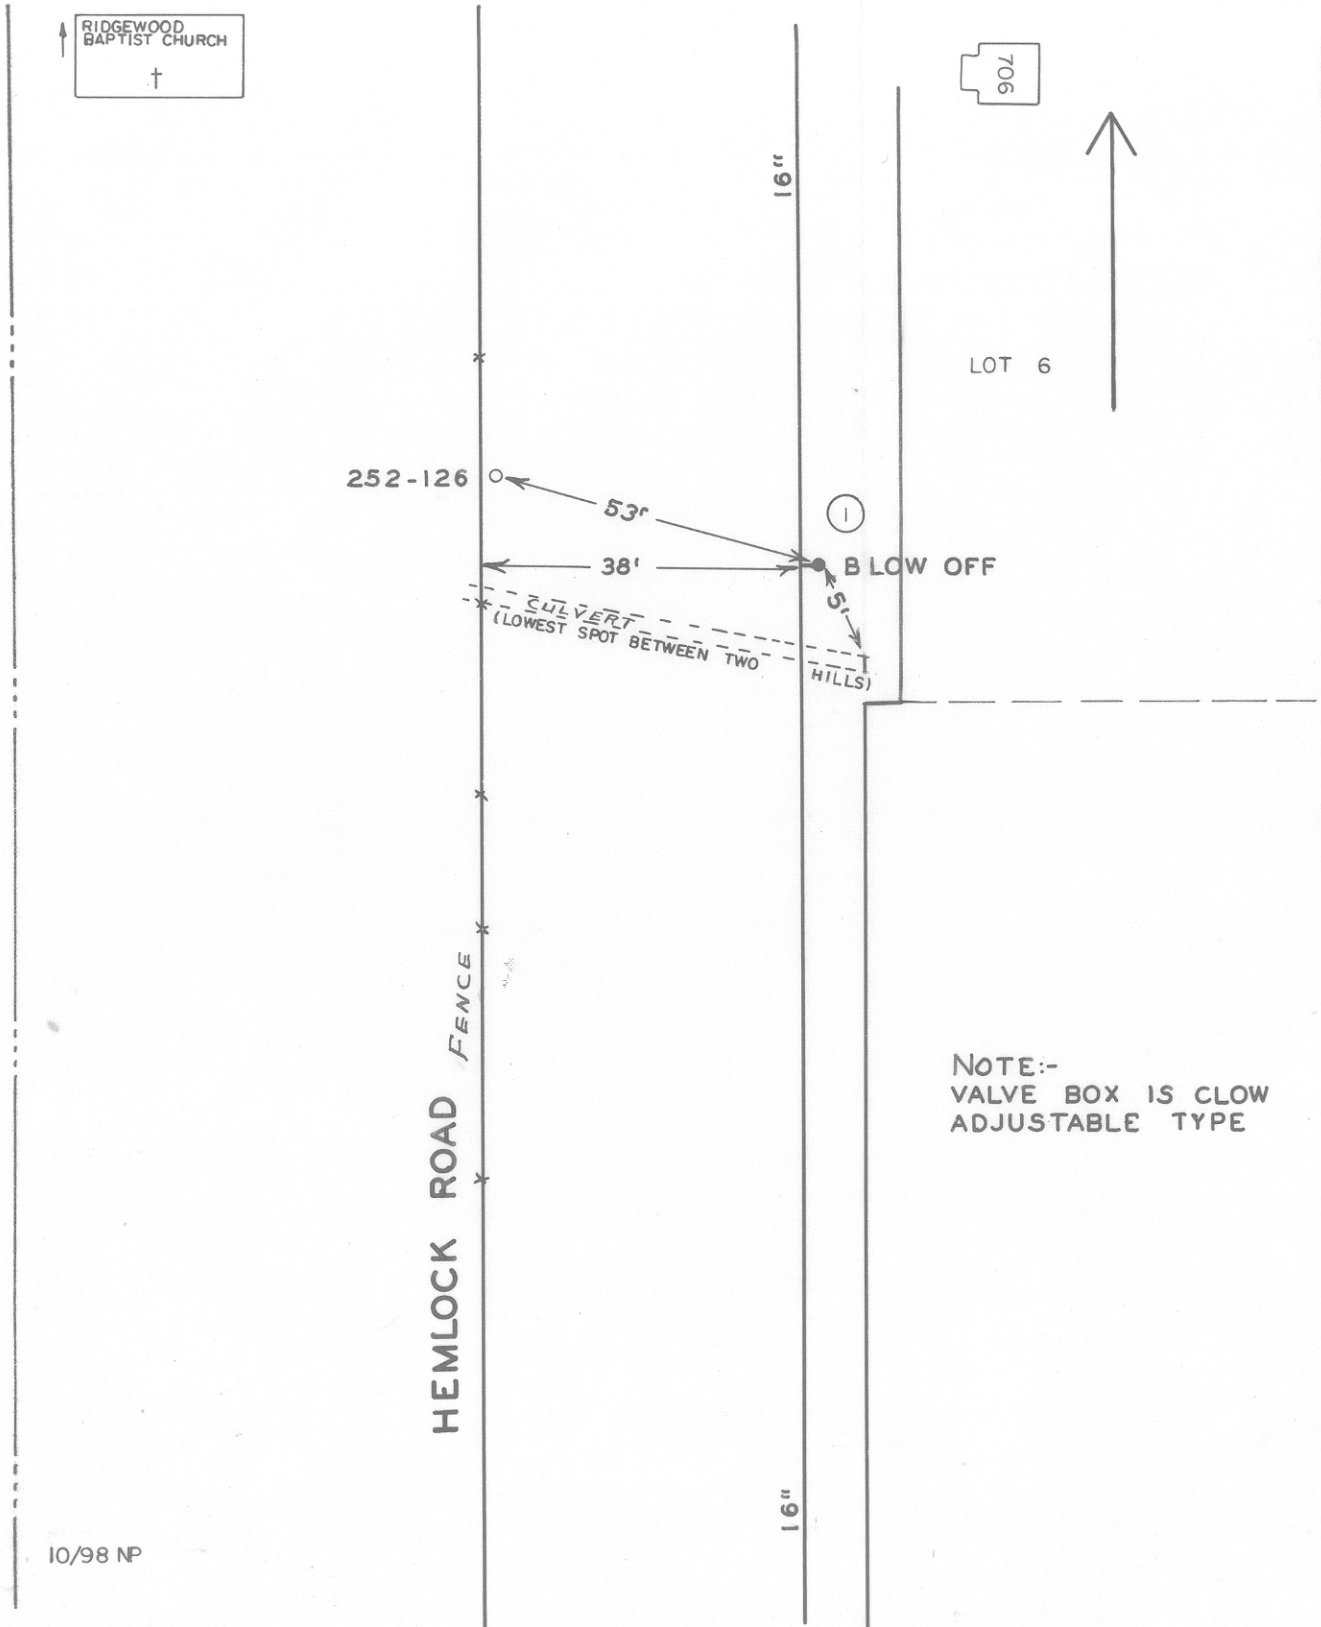

DATE	NO.	SIZE	MAKE	OPEN	TURNS
6-63	1	6"	DARLING	R	20

NOTE:-
VALVE BOX IS CLOW
ADJUSTABLE TYPE

10/98 NP

CITY OF ROANOKE—WATER DEPT.

VALVE DIAGRAM

HEMLOCK ROAD 300±

NORTH OF OAK ROAD N.W.

SEC. MAP 50, 604, 606

DATE PAGE NO.