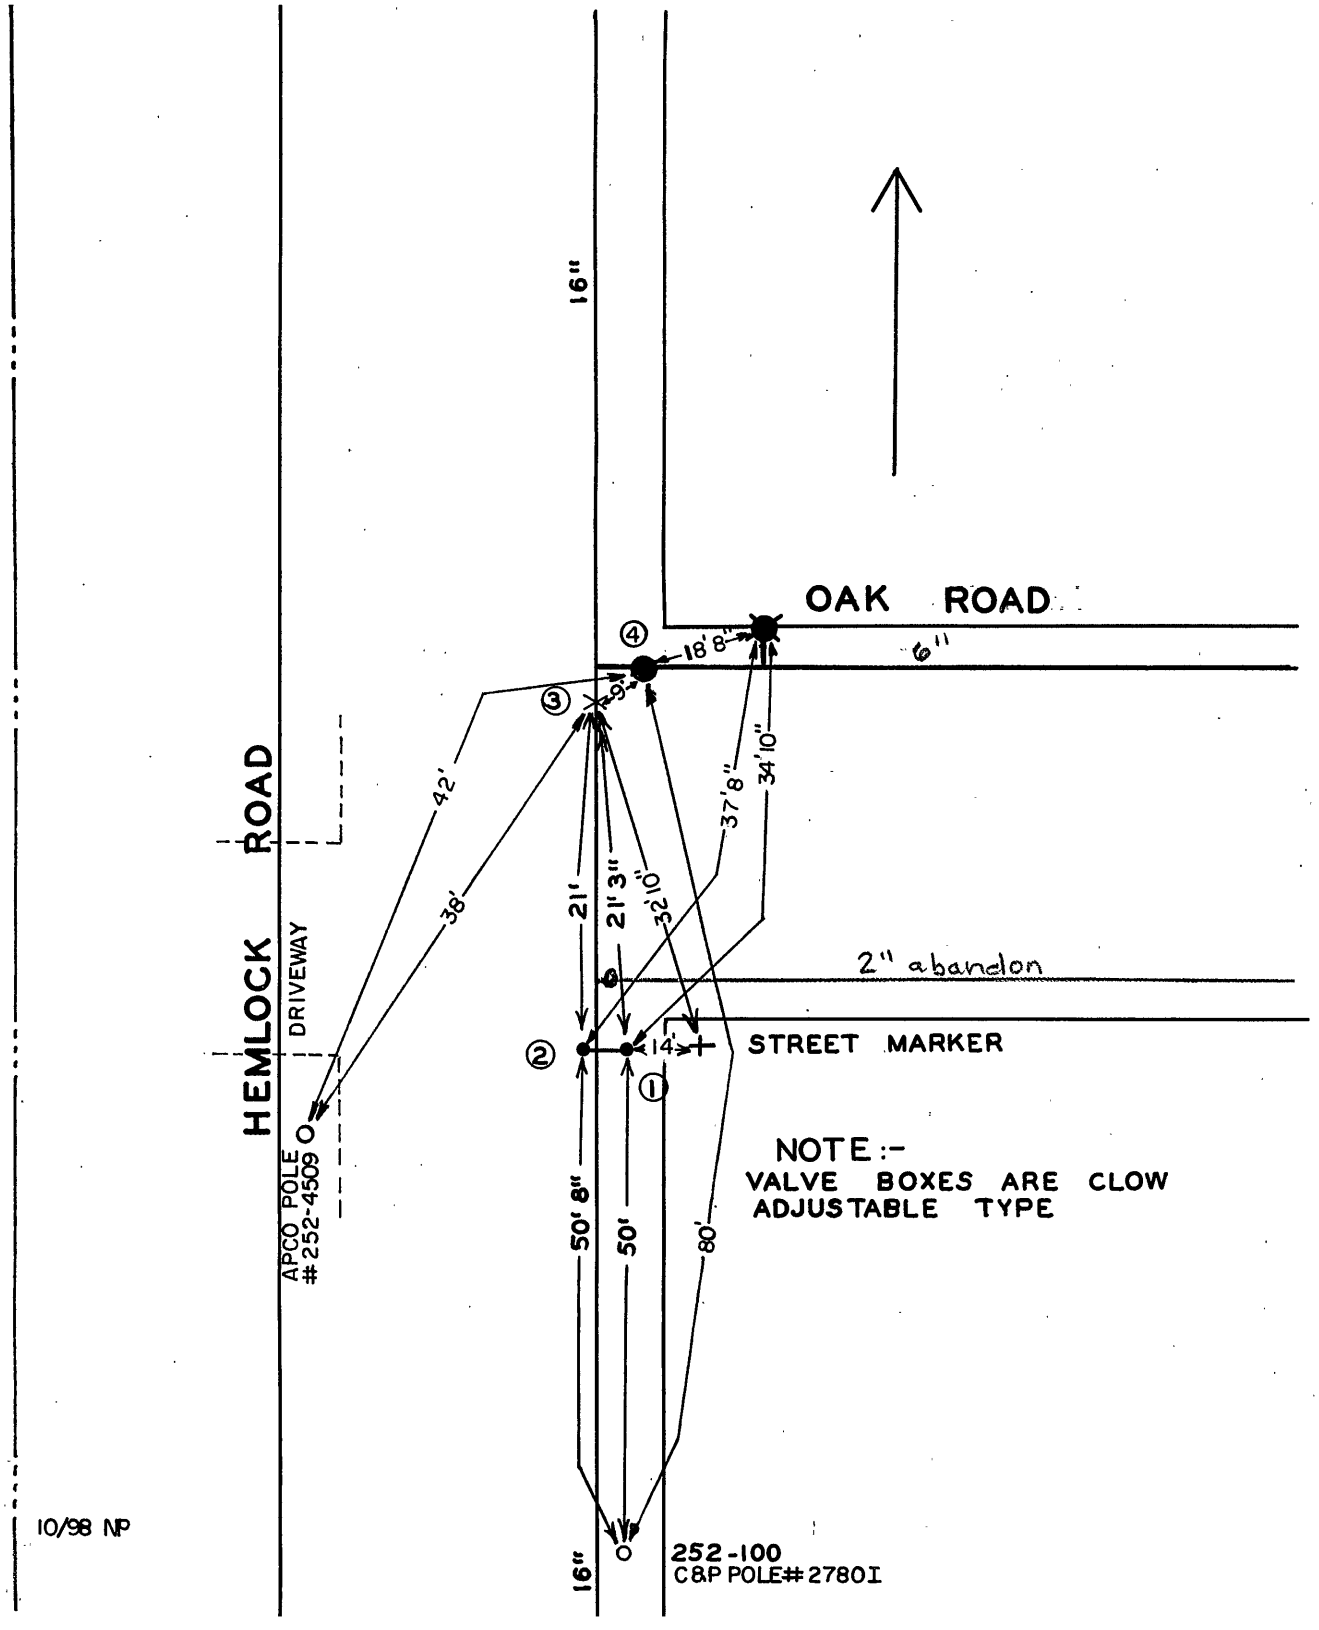

DATE	NO.	SIZE	MAKE	OPEN	TURNS
6-63	1	16"	#1 BOX DARLING	R	105
6-53	2	3"	#1 BOX BY PASS		
6-53	3	1"	AIR COCK		
12-90	4	6"	MUELLER	R	21

CITY OF ROANOKE—WATER DEPT.

VALVE DIAGRAM

HEMLOCK ROAD &

OAK ROAD N. W.

SEC. MAP 604

DATE **PAGE NO.**

10/98 NP