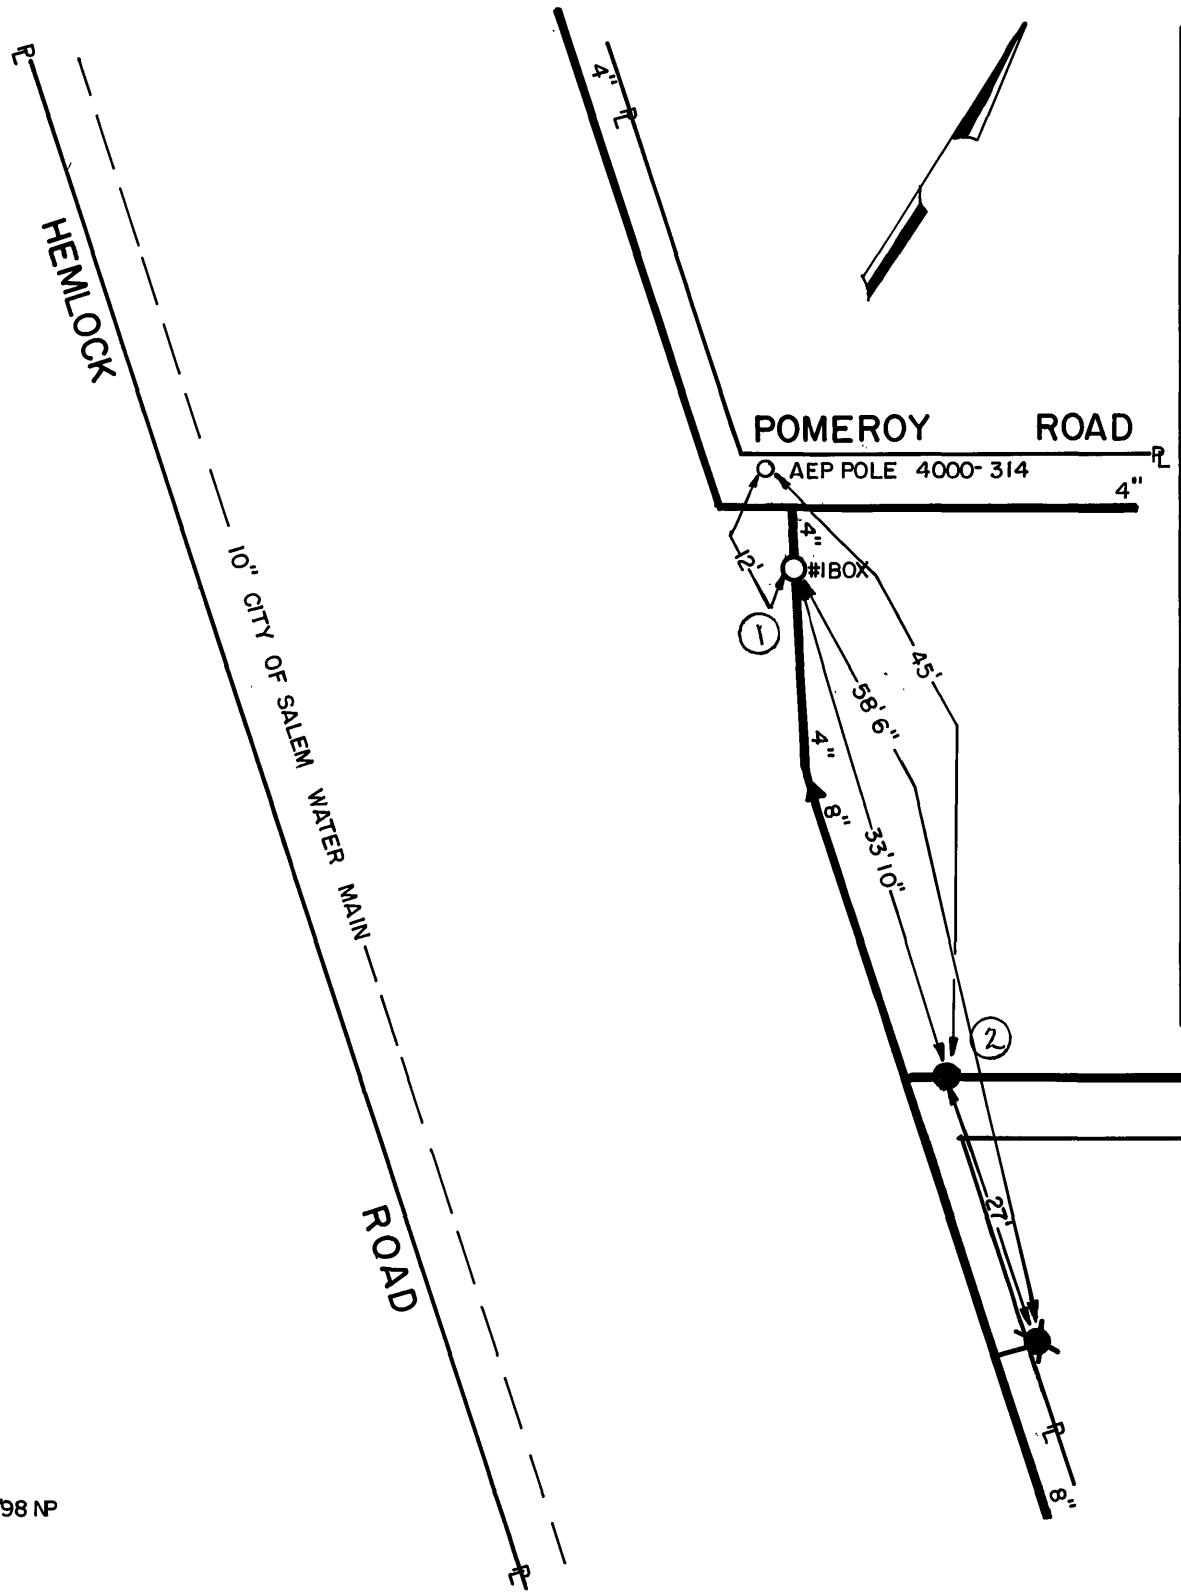

DATE	NO.	SIZE	MAKE	OPEN	TURNS
1991	1	4"	MUELLER	R	
1998	2	6"	AM. DARLING	R	21

CITY OF ROANOKE - WATER DEP'T.

VALVE DIAGRAM

HEMLOCK ROAD

POMEROY ROAD

SEC. MAP 606 N.W.

DATE: PAGE NO.

10/98 NP