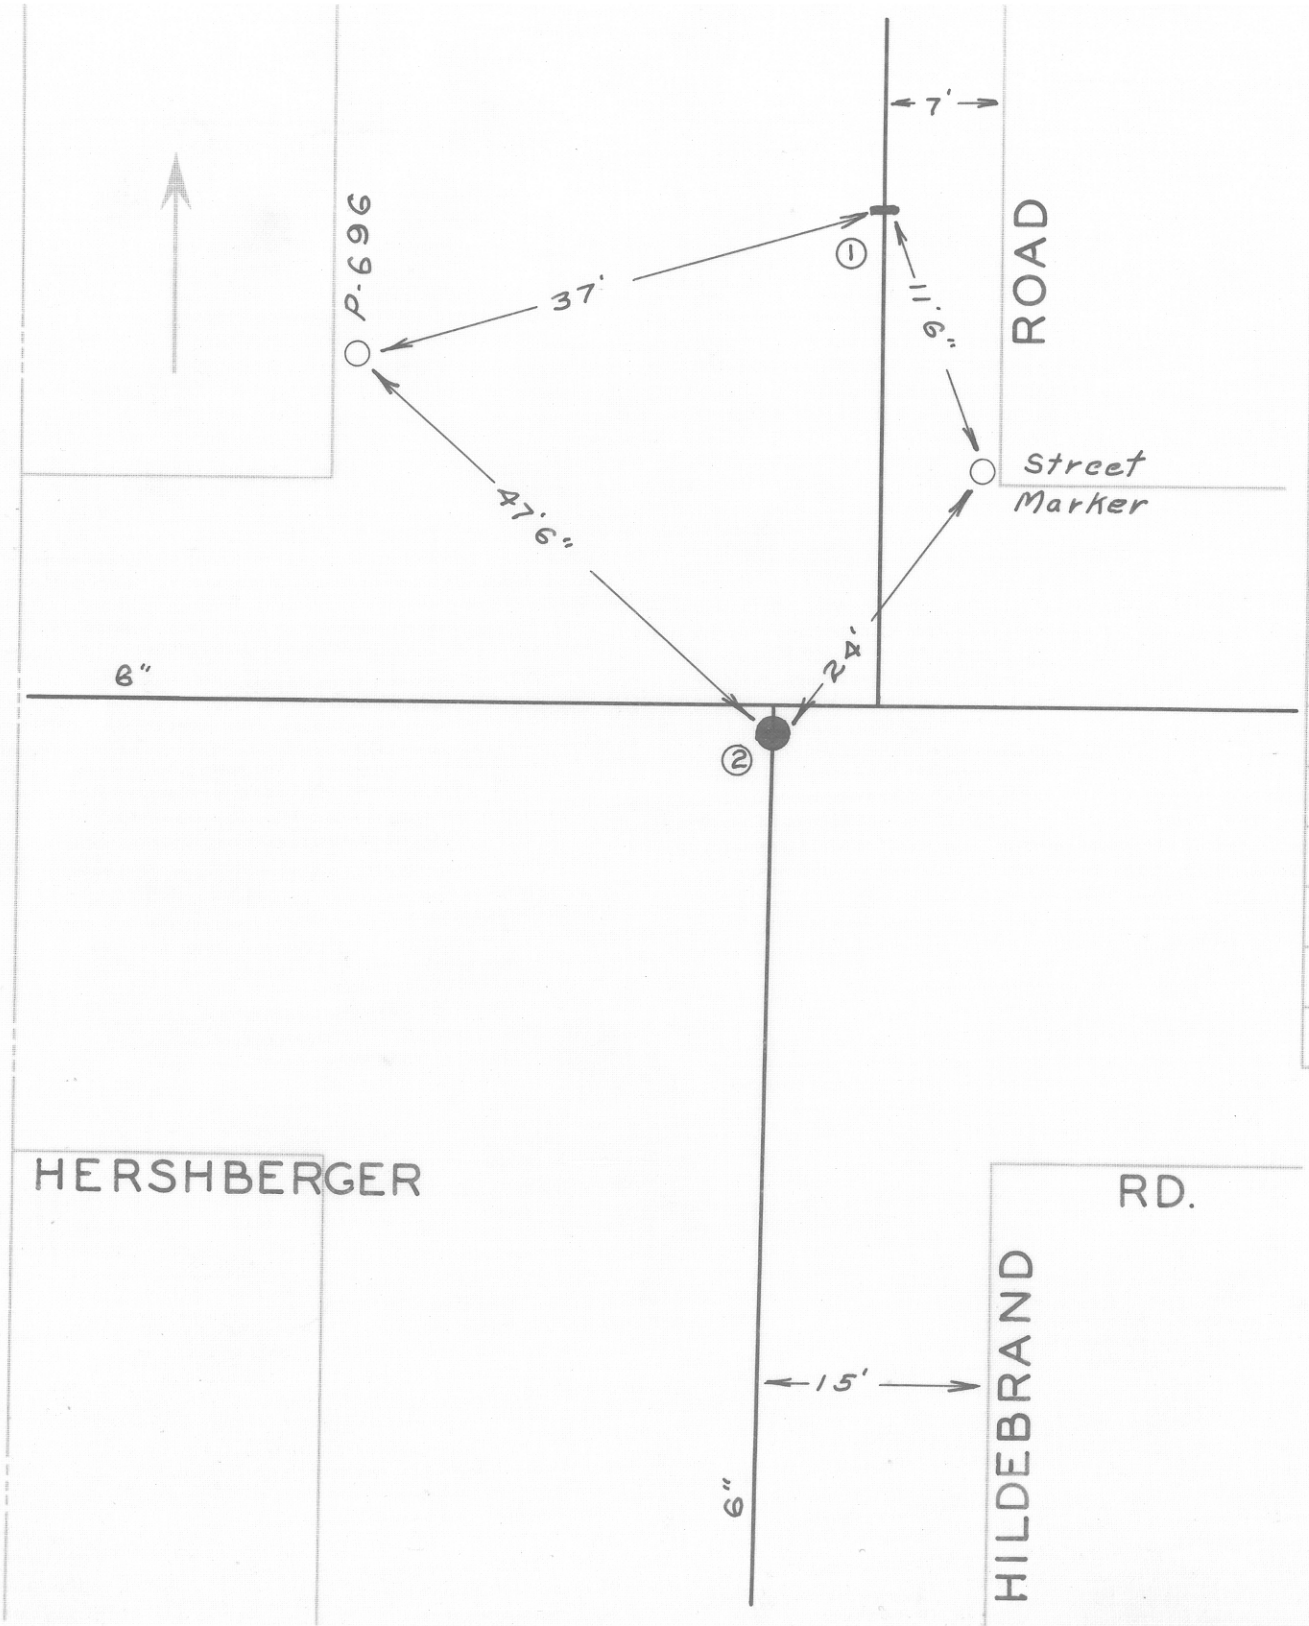

DATE	NO.	SIZE	MAKE	OPEN	TURNS
	1	6"			
	2	6"			
	1	8'-N	NPL		
	2	38'-N	SPL		

CITY OF ROANOKE—WATER DEP'T

VALVE DIAGRAM

HERSHBERGER RD. &

HILDEBRAND RD. N.W.

SEC. MAP 220

DATE PAGE NO.