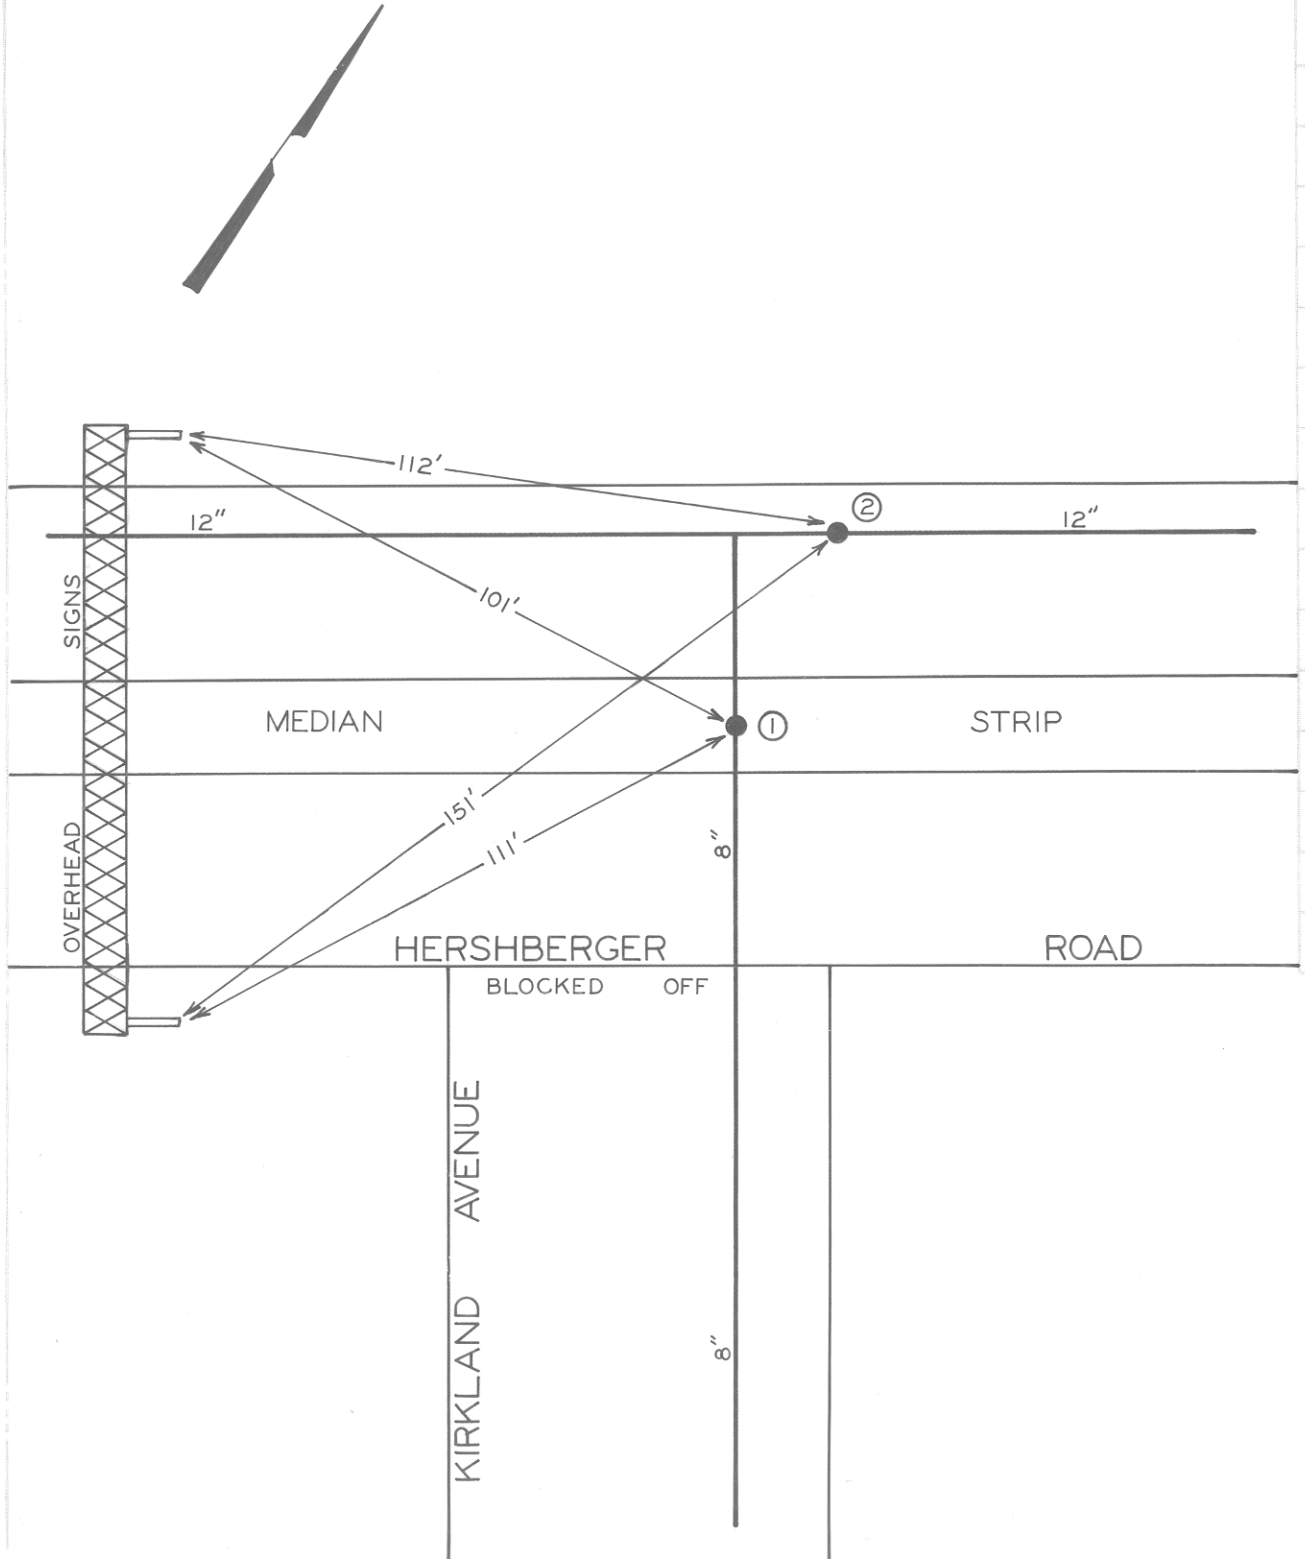

DATE	NO.	SIZE	MAKE	OPEN	TURNS
	1	8"		R	
	2	12"		R	

CITY OF ROANOKE—WATER DEP'T

VALVE DIAGRAM

HERSHBERGER ROAD &
KIRKLAND AVENUE N.W.

SEC. MAP 248

DATE PAGE NO.