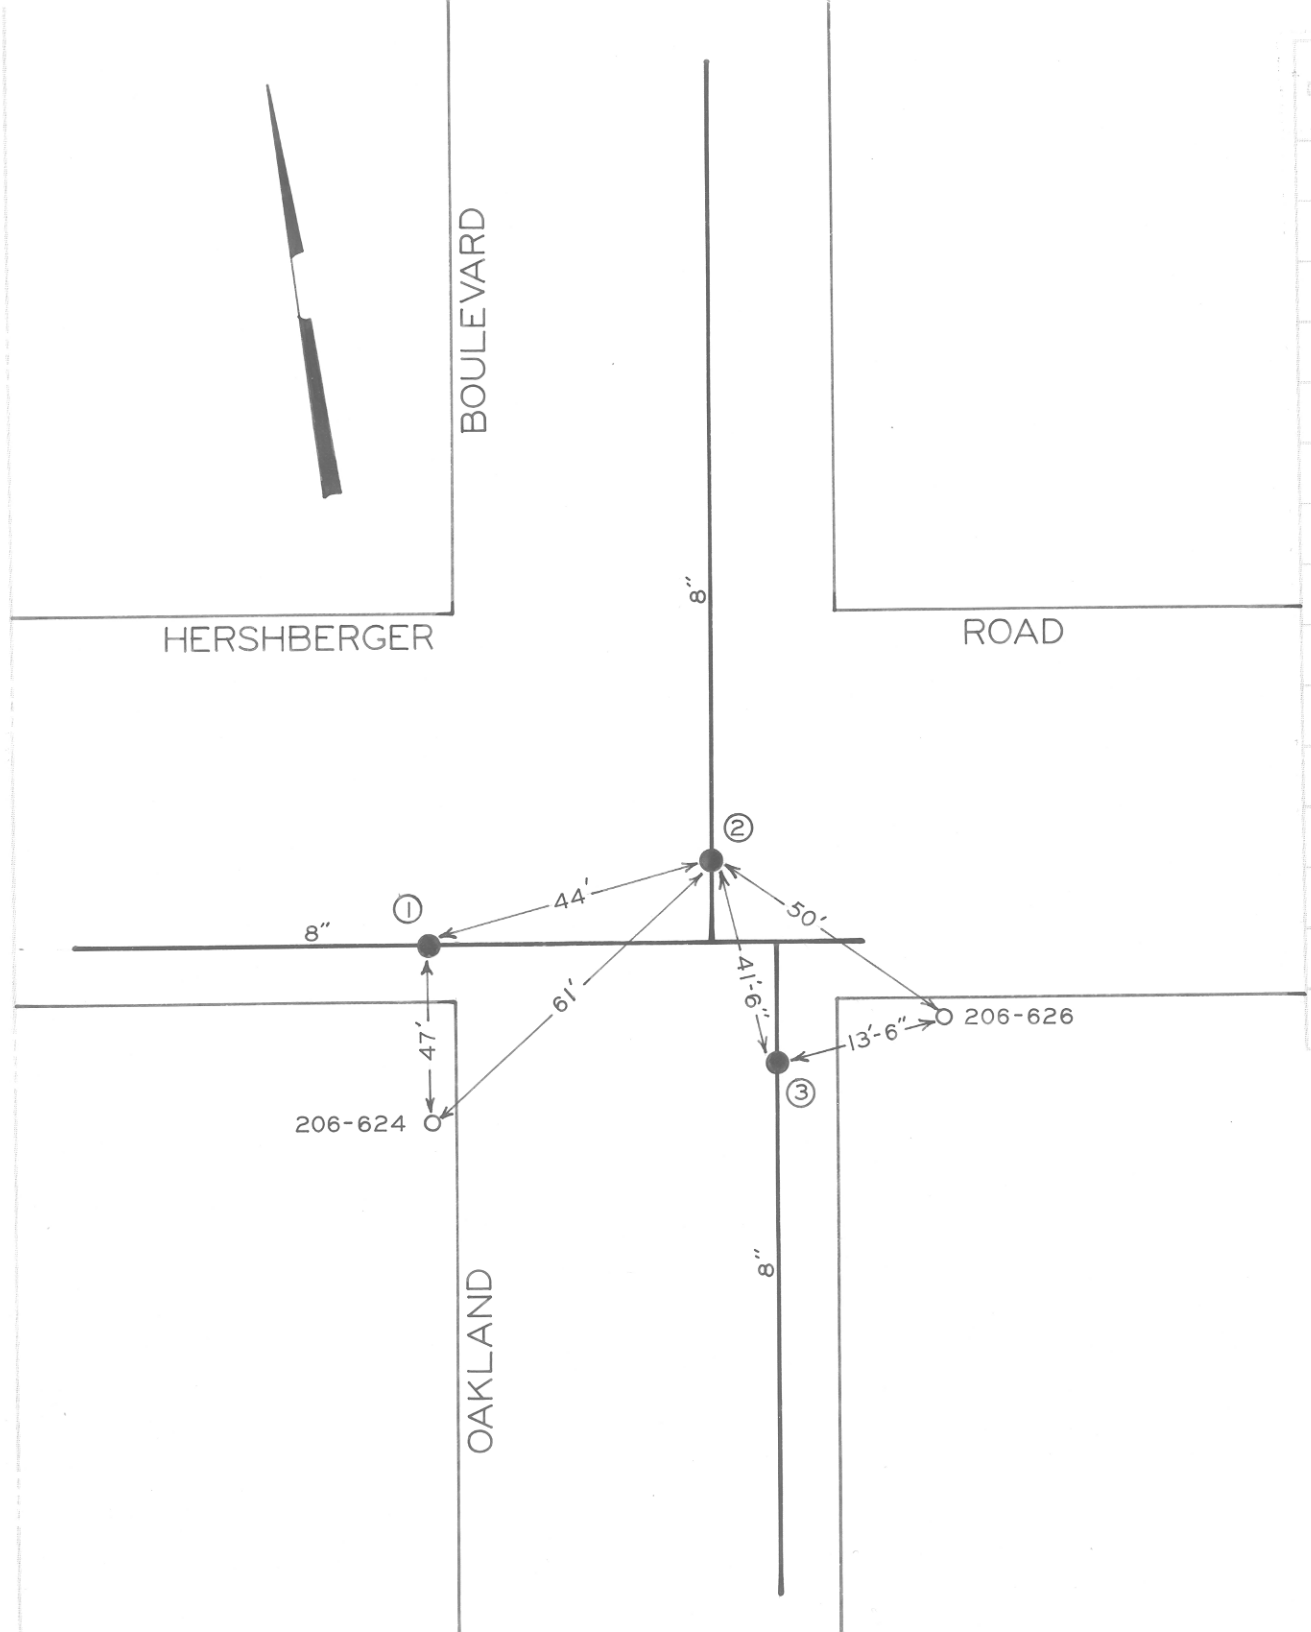

DATE	NO.	SIZE	MAKE	OPEN	TURNS
65	1	8"		R	27
65	2	8"		R	27
65	3	8"		R	27

CITY OF ROANOKE—WATER DEP'T

VALVE DIAGRAM

HERSHBERGER ROAD &
OAKLAND BOULEVARD N.E.
OR N.W.

SEC. MAP 218

DATE PAGE NO.