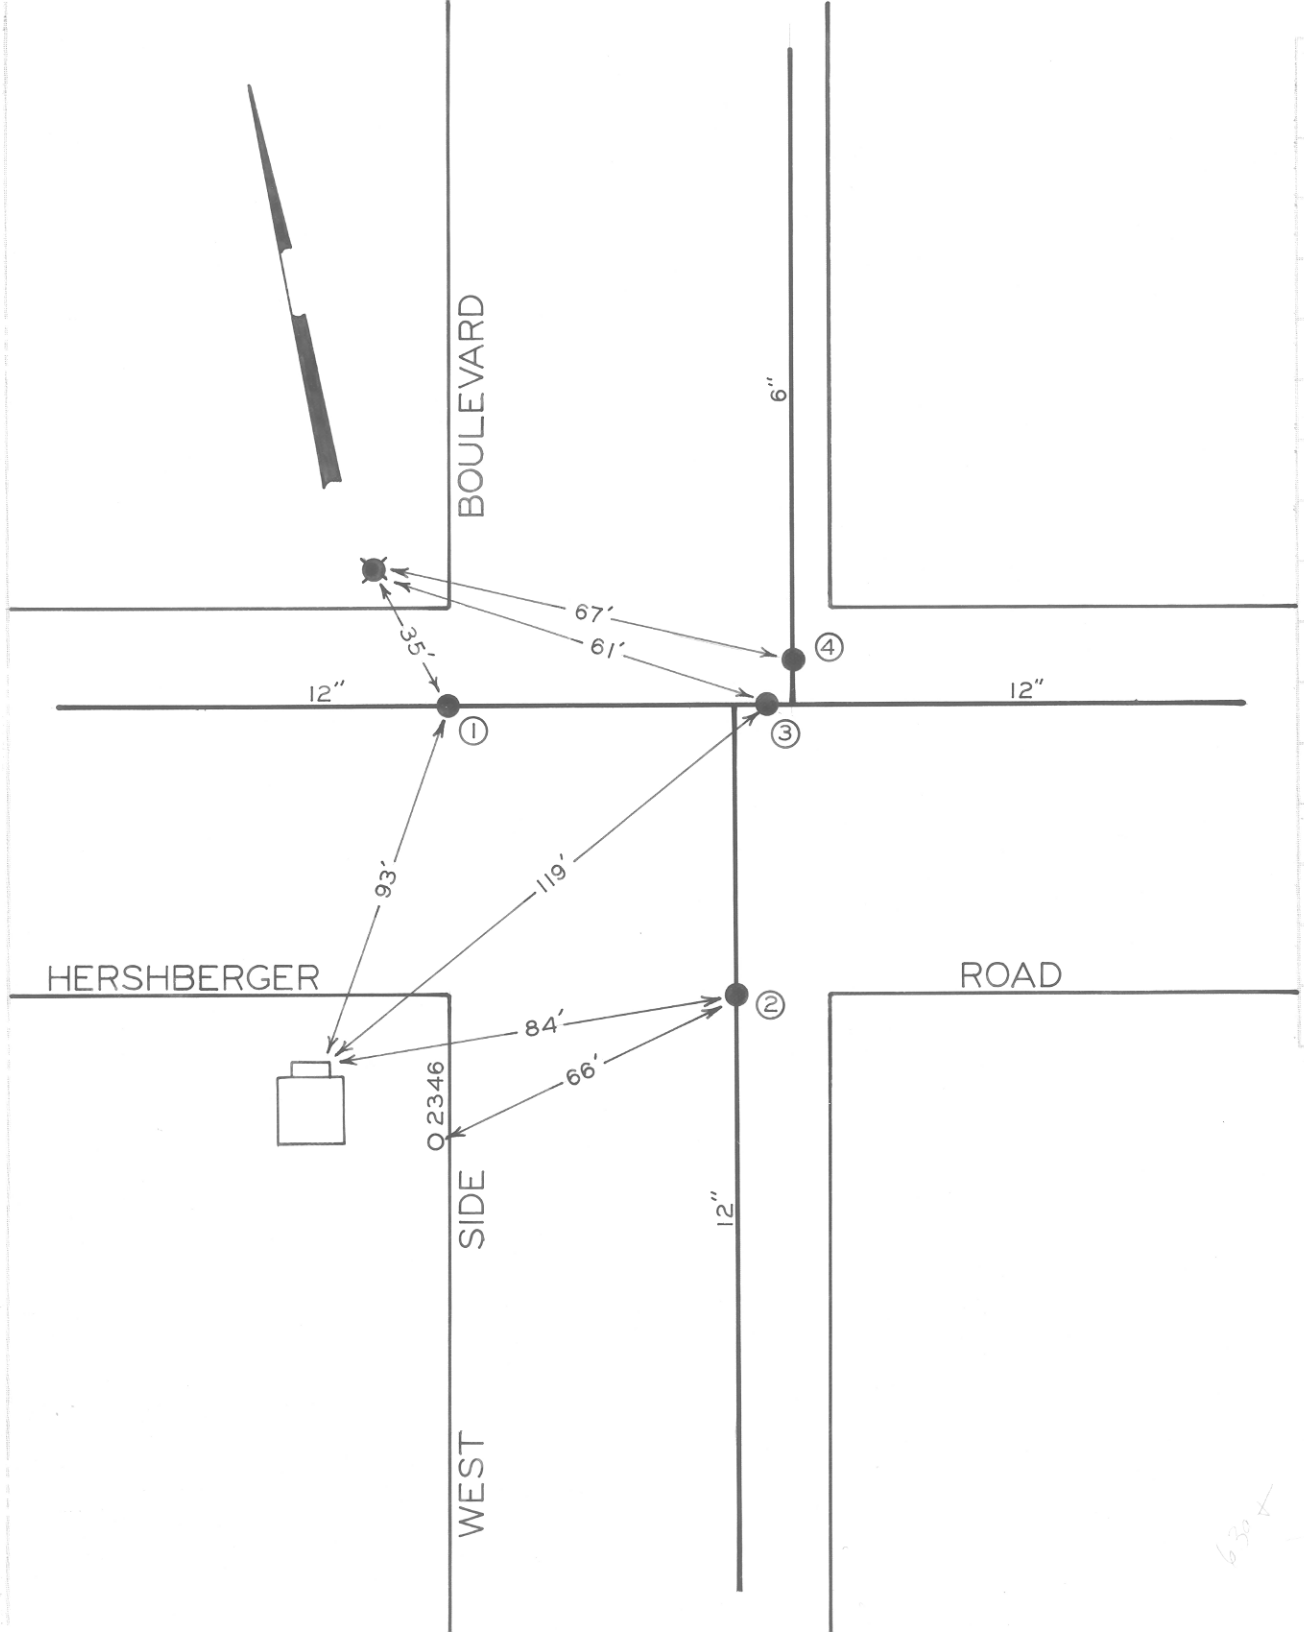

DATE	NO.	SIZE	MAKE	OPEN	TURNS
	1	12"	MUELLER	R	38
	2	12"	MUELLER	R	38
	3	12"	MUELLER	R	38
69	4	6"		R	21

CITY OF ROANOKE—WATER DEP'T

VALVE DIAGRAM

HERSHBERGER ROAD & WEST SIDE BOULEVARD N.W.

SEC. MAP 5 & 267

DATE PAGE NO.