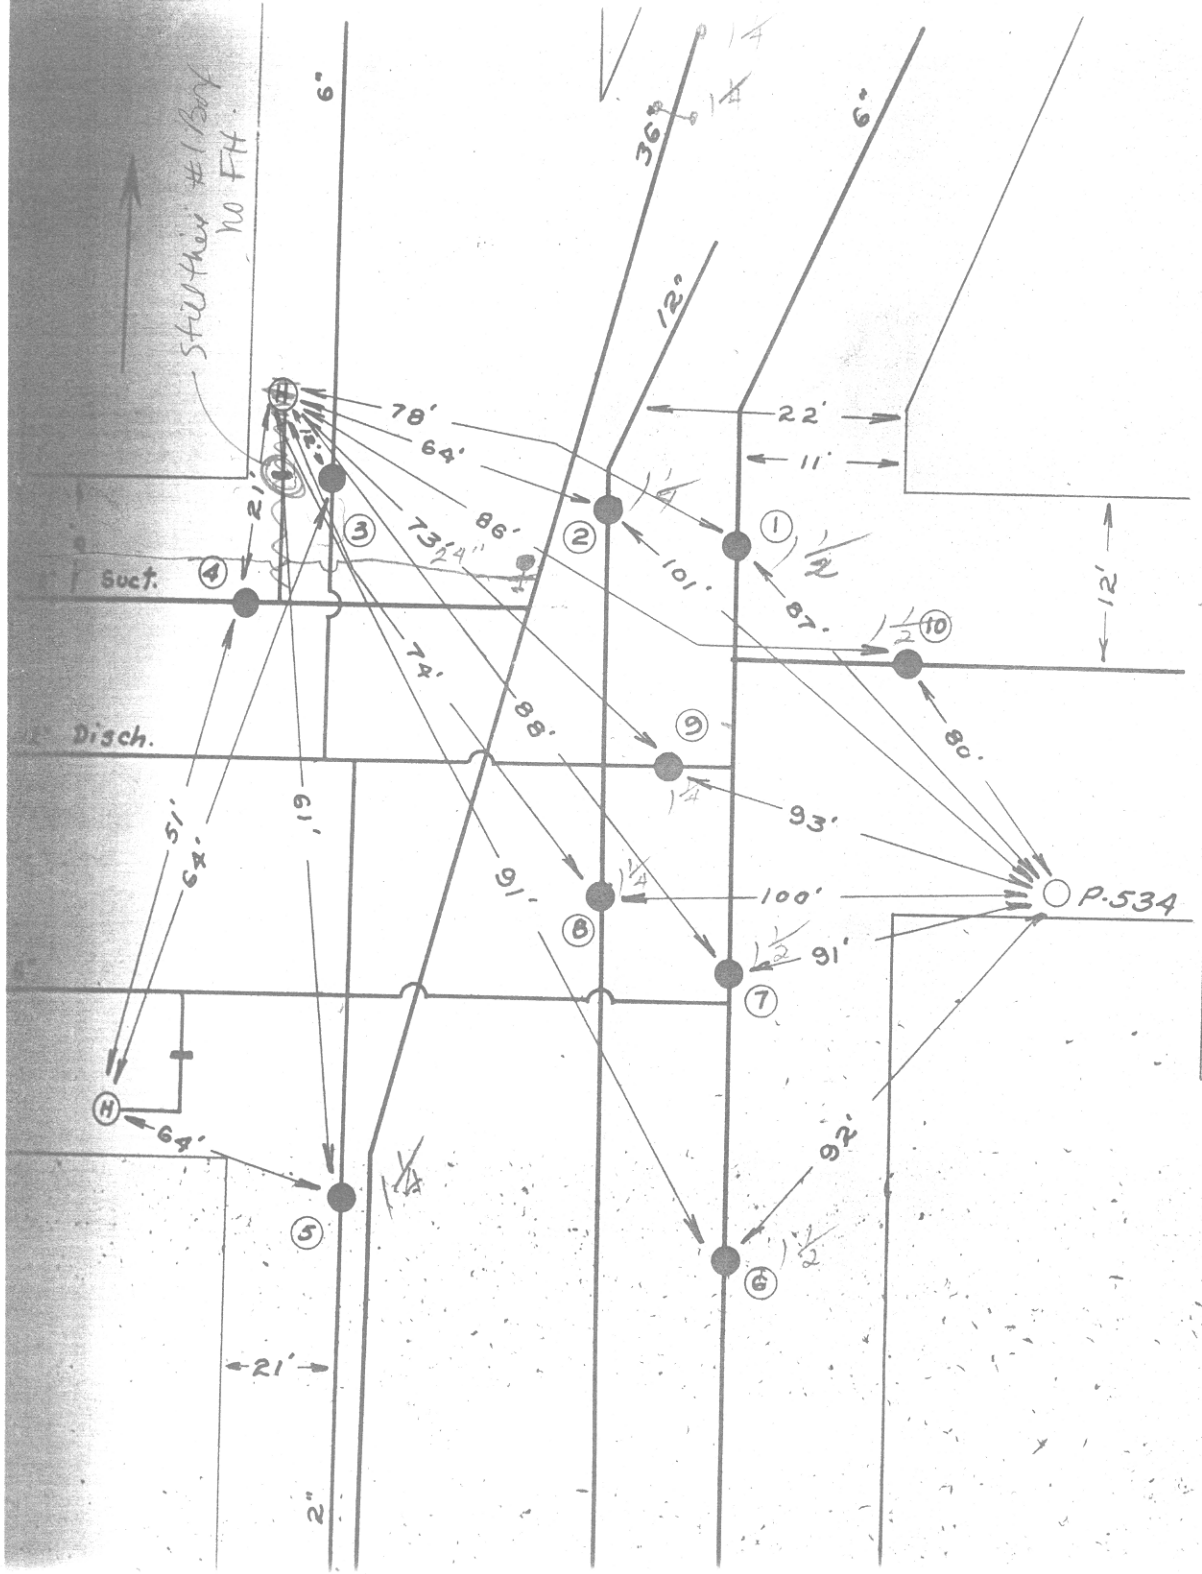


| DATE | NO. | SIZE | MAKE | OPEN | TURNS |
|---|---|---|---|---|---|
| | 1 | 6" | | | |
| | 2 | 12" | | | |
| | 3 | 6" | #3 opens to the | Left | |
| | 4 | 12" | | | |
| | 5 | 2" | | | |
| | 6 | 6" | | | |
| | 7 | 6" | | | |
| | 8 | 12" | | | |
| | 9 | 6" | | | |
| | 10 | 6" | | | |
| | | | | | |
| | | | | | |
| | | | | | |
| | | | | | |
| | 1 | 7'-S | NPL | | |
| | 2 | 4'-S | NPL | | |
| | 3 | 0 | NPL | | |
| | 4 | 0 | WPL | | |
| | 5 | 4'-S | SPL | | |
| | 6 | 15'-S | SPL | | |
| | 7 | 10'-S | SPL | | |
| | 8 | 0 | SPL | | |
| | 9 | 16'-N | SPL | | |
| | 10 | 0 | EPL | | |
| | | | | | |

CITY OF ROANOKE—WATER DEP'T

VALVE DIAGRAM

HERSHBERGER RD. &

WILLIAMSON RD. N.W.

SEC. MAP