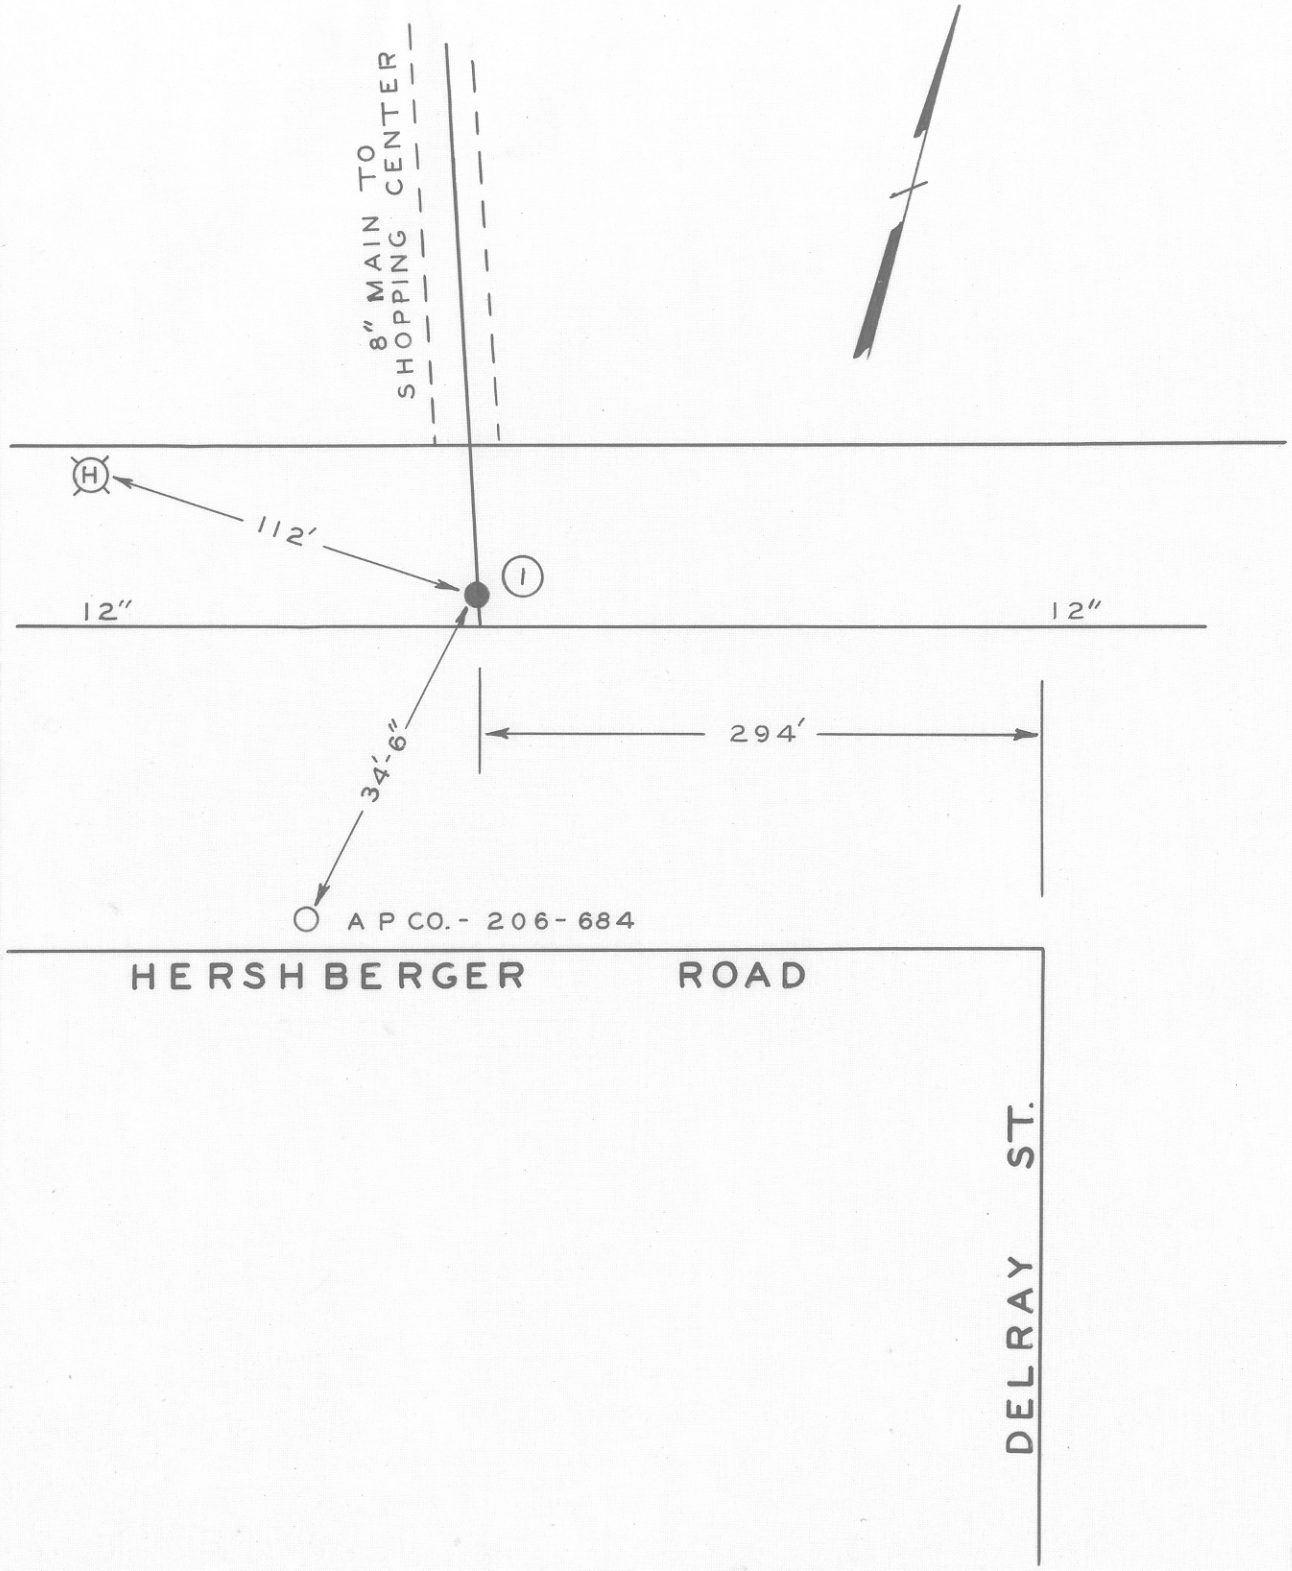

DATE	NO.	SIZE	MAKE	OPEN	TURNS
'61	1	8"	DAR.	R	26½

CITY OF ROANOKE—WATER DEPT.

VALVE DIAGRAM

HERSHBERGER RD. N.W.

294' W. OF DELRAY ST.

SEC. MAP 228

DATE PAGE NO.

"IMPERIAL" TRACING CLOTH
K & E CO., N. Y.