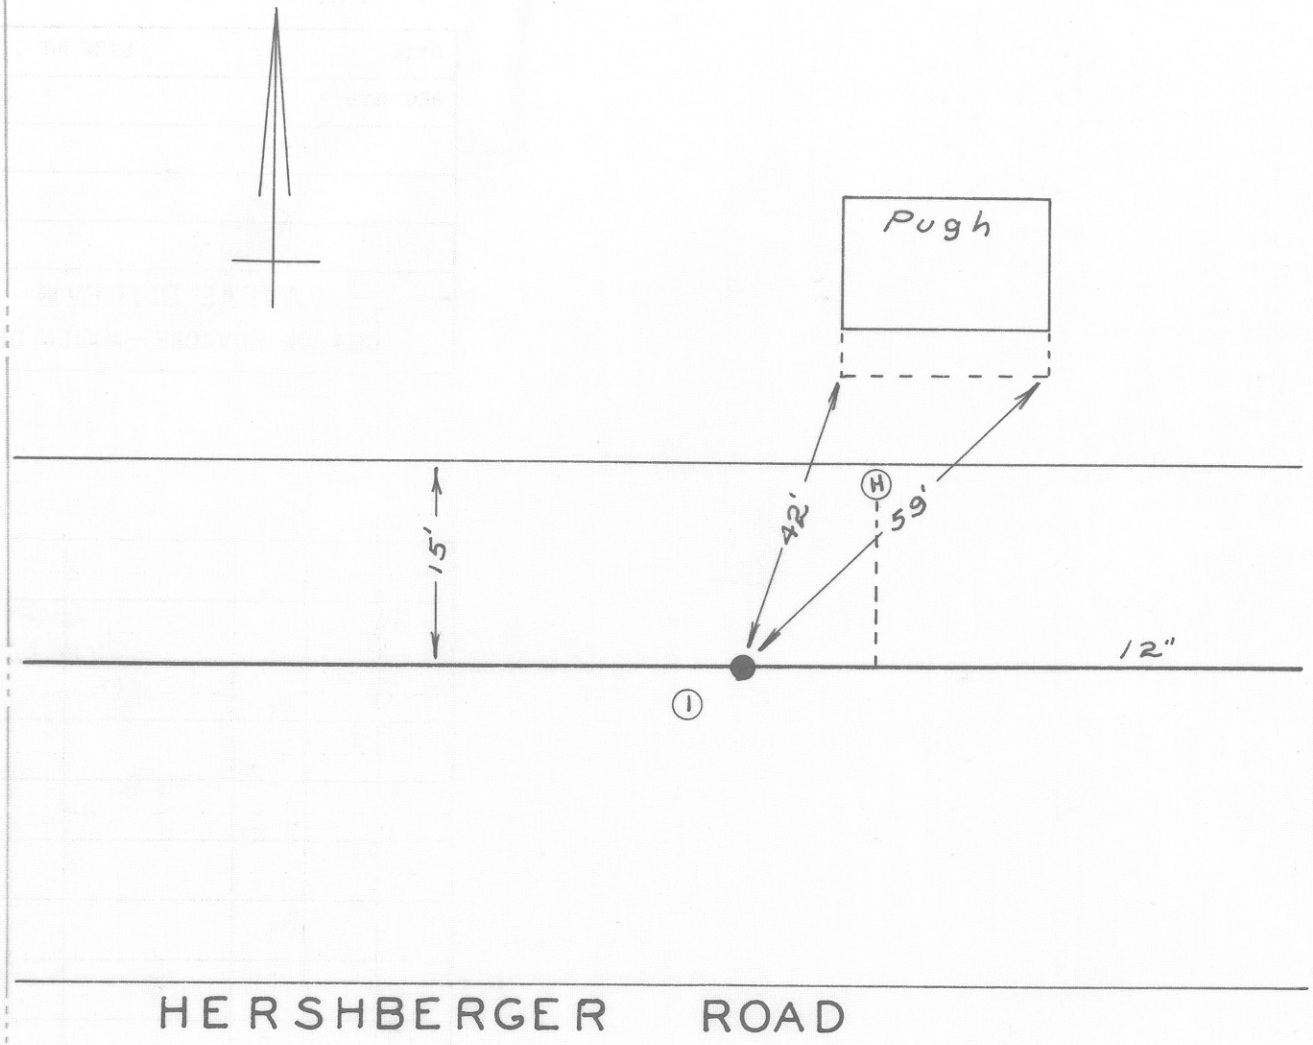

DATE	NO.	SIZE	MAKE	OPEN	TURNS
	1	12"	MUELLER	R	38
	1	1605'-W	WPL	COVE	RD.

CITY OF ROANOKE—WATER DEPT.

VALVE DIAGRAM

HERSHBERGER RD. BET.

COVE RD. & WEST SIDE BLVD.

AT PUGHS RESIDENCE

SEC. MAP 256

DATE PAGE NO.

"IMPERIAL" TRACING CLOTH.
K & E CO., N. Y.