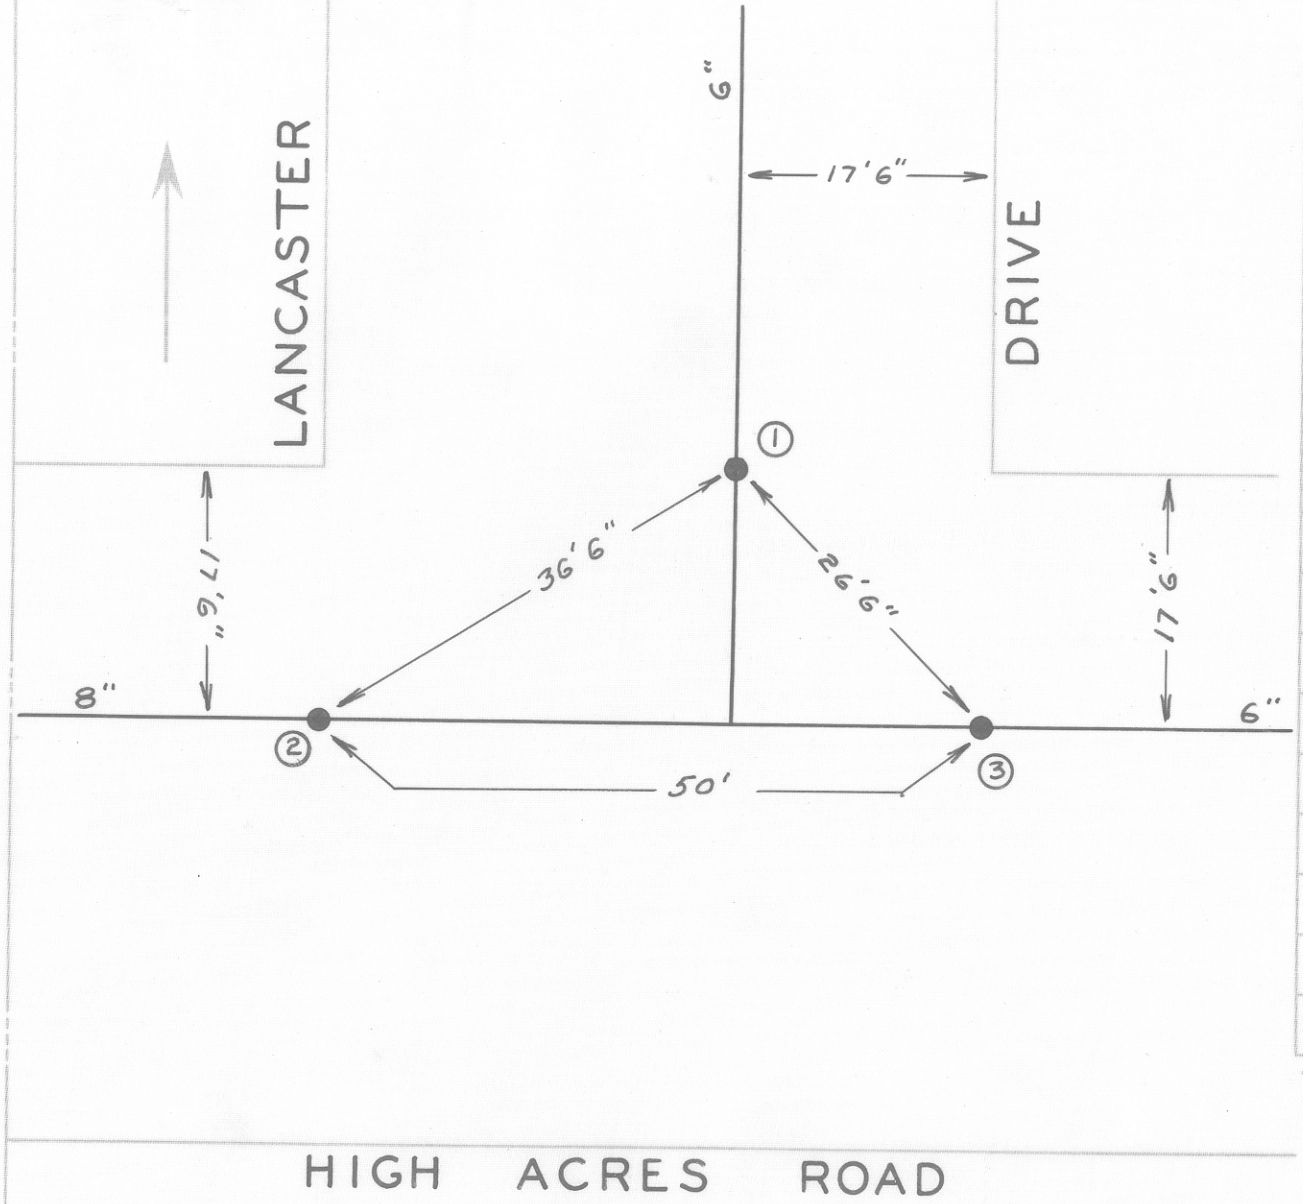

DATE	NO.	SIZE	MAKE	OPEN	TURNS
1957	1	6"	MUELLER	R	20½
1957	2	8"	MUELLER	R	28
1957	3	6"	MUELLER	R	20½
	1	0	NPL		
	2	0	WPL		
	3	0	EPL		

639

CITY OF ROANOKE—WATER DEP'T

VALVE DIAGRAM

HIGH ACRES RD. &

LANCASTER DR. N.W.

SEC. MAP 5

DATE PAGE NO.