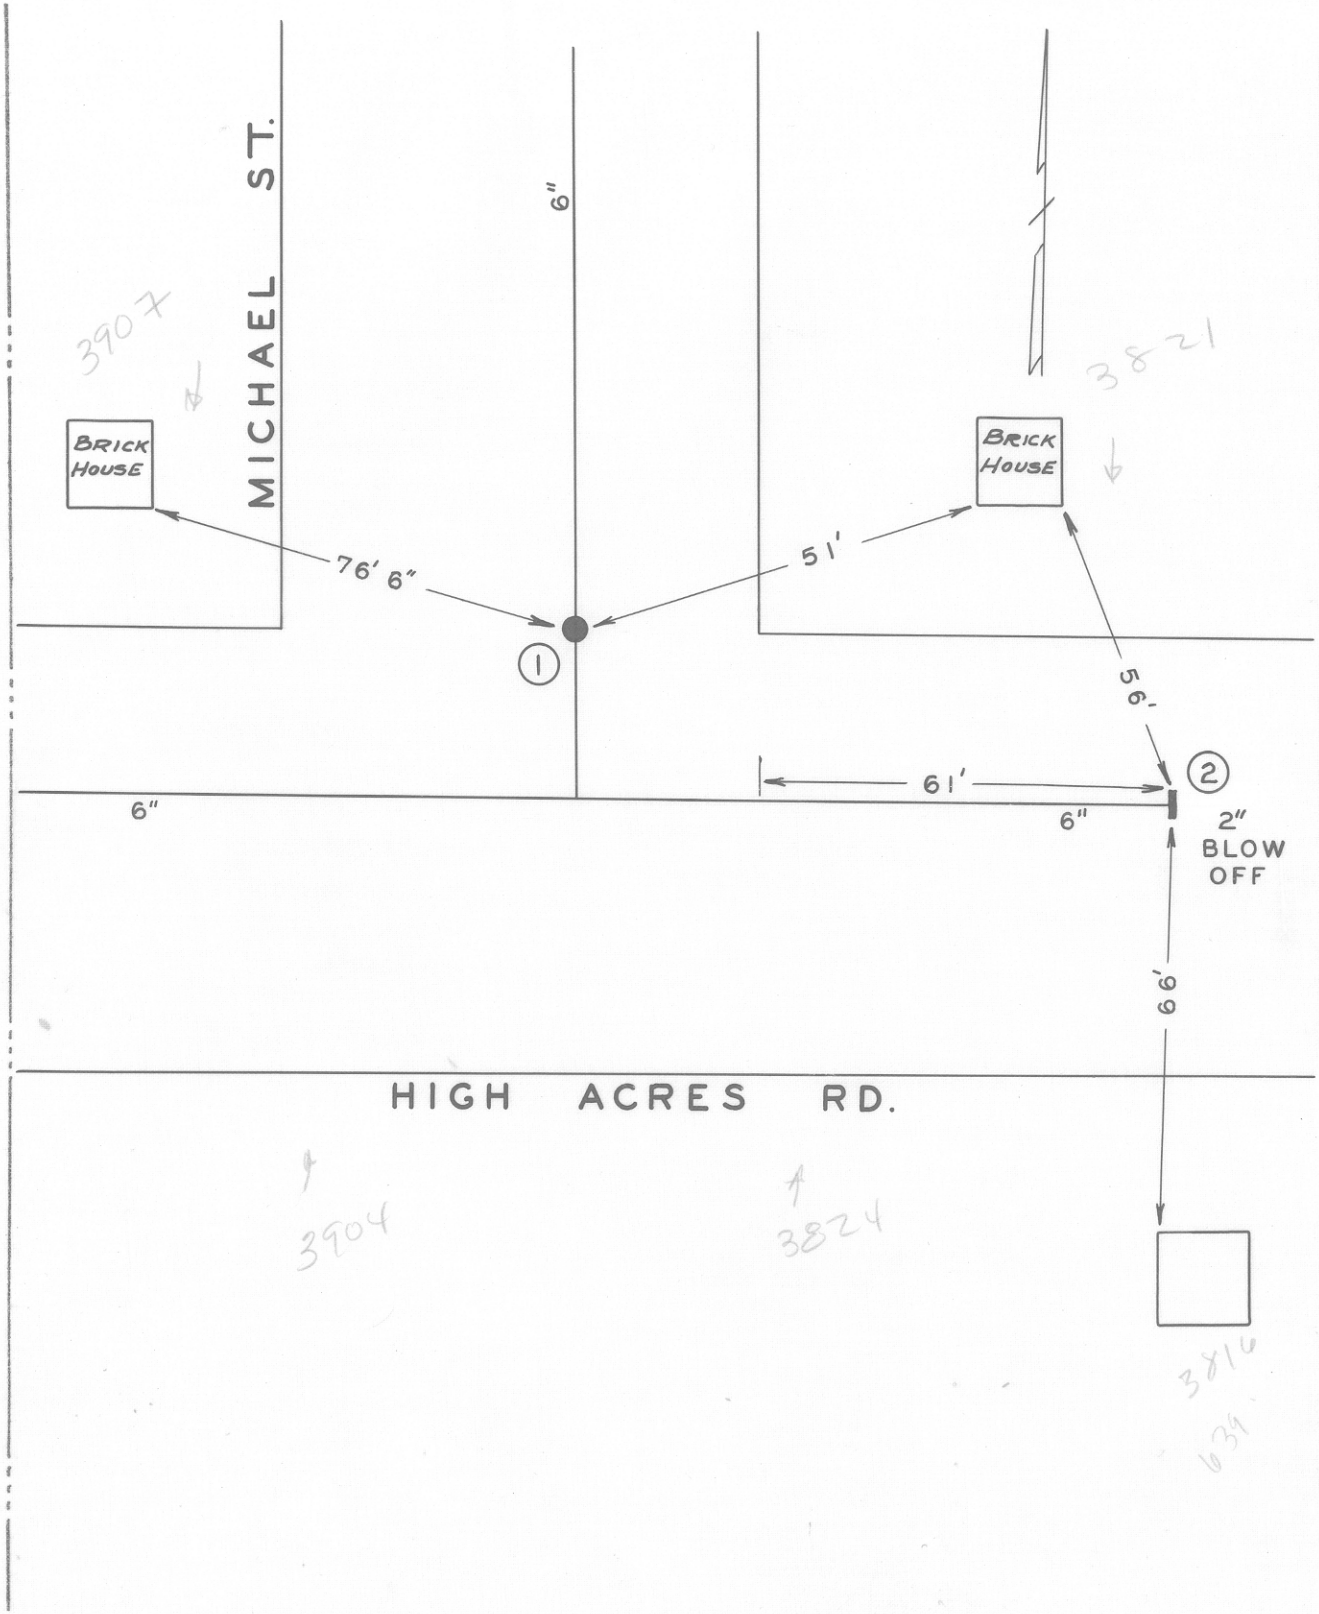

DATE	NO.	SIZE	MAKE	OPEN	TURNS
	1	6"	MUE.	R	20½
'62	2	2"	MISC.	L	
	1	0	NPL		
	2	61'-E	EPL		

CITY OF ROANOKE—WATER DEPT.

VALVE DIAGRAM

HIGH ACRES RD. &

MICHAEL ST. N.W.

SEC. MAP 4

DATE PAGE NO.