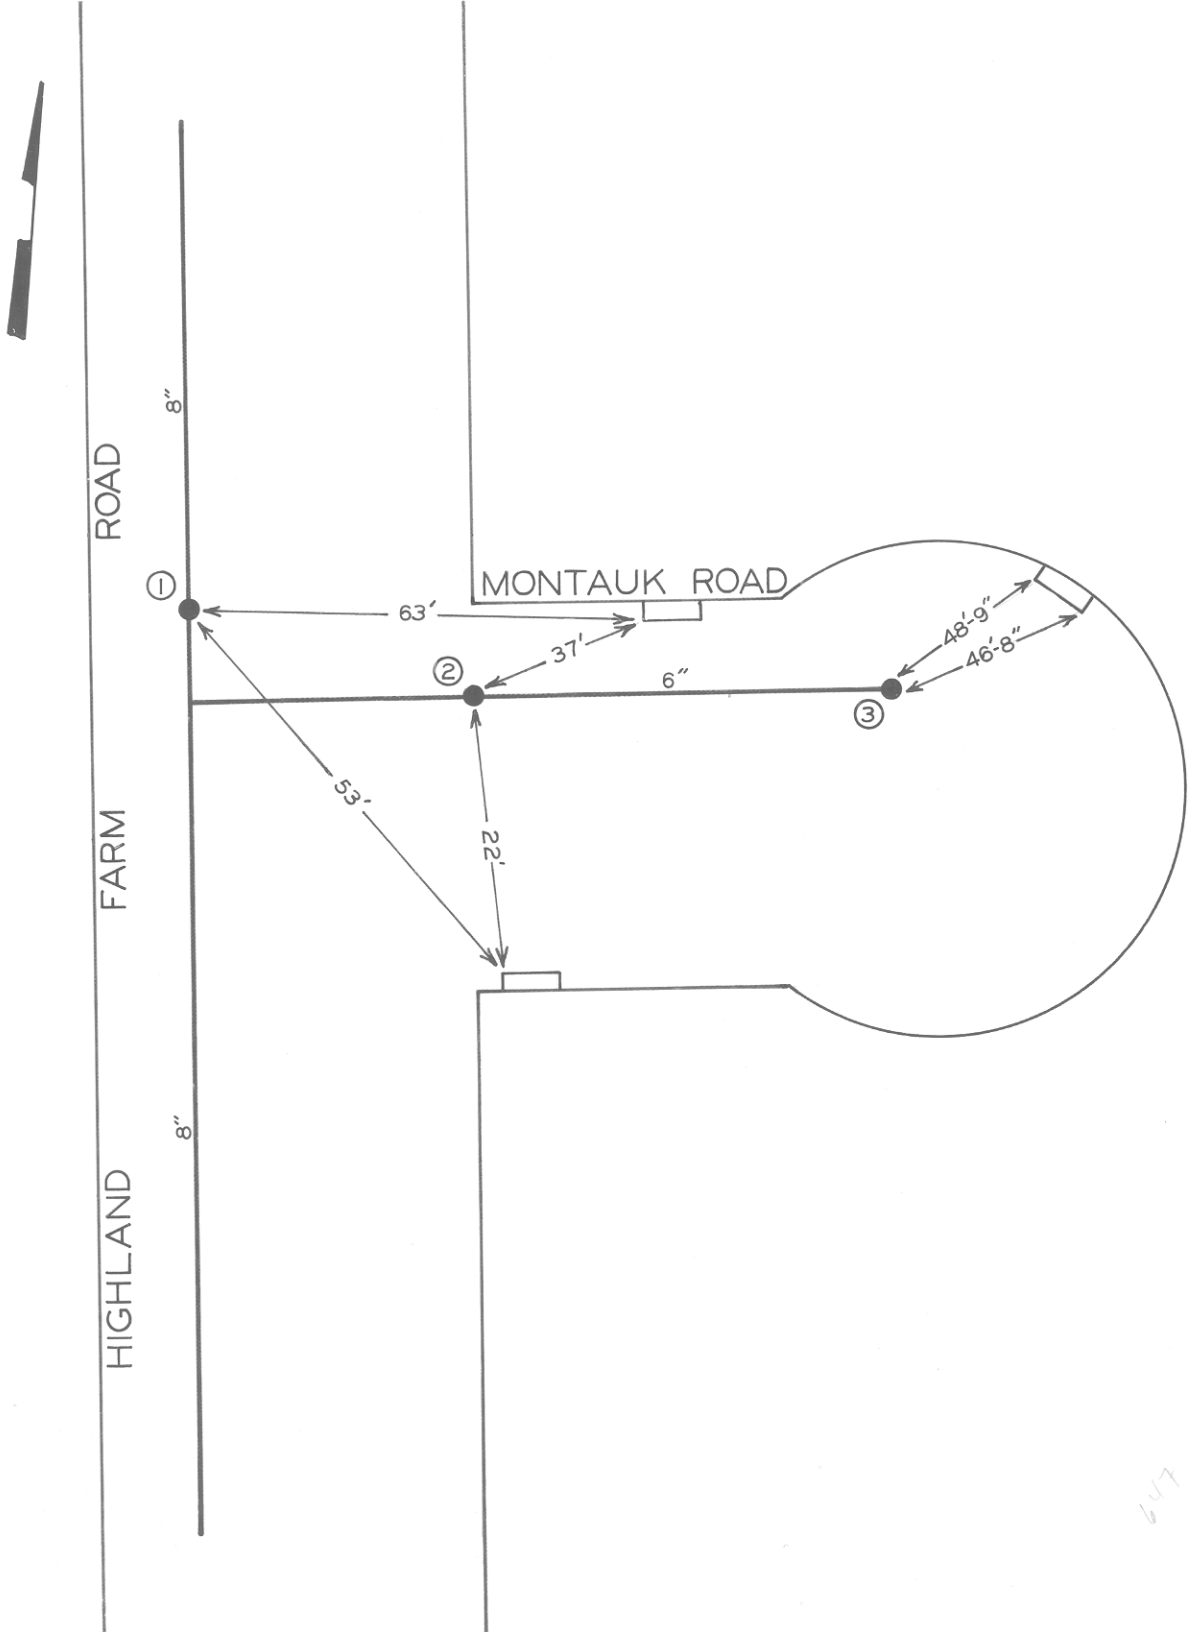

DATE	NO.	SIZE	MAKE	OPEN	TURNS
69	1	8"	MUELLER	R	27
69	2	6"	MUELLER	R	21
69	3	2"	BLOW OFF	L	

CITY OF ROANOKE—WATER DEP'T

VALVE DIAGRAM

HIGHLAND FARM ROAD &
MONTAUK ROAD N.W.

SEC. MAP

DATE PAGE NO.