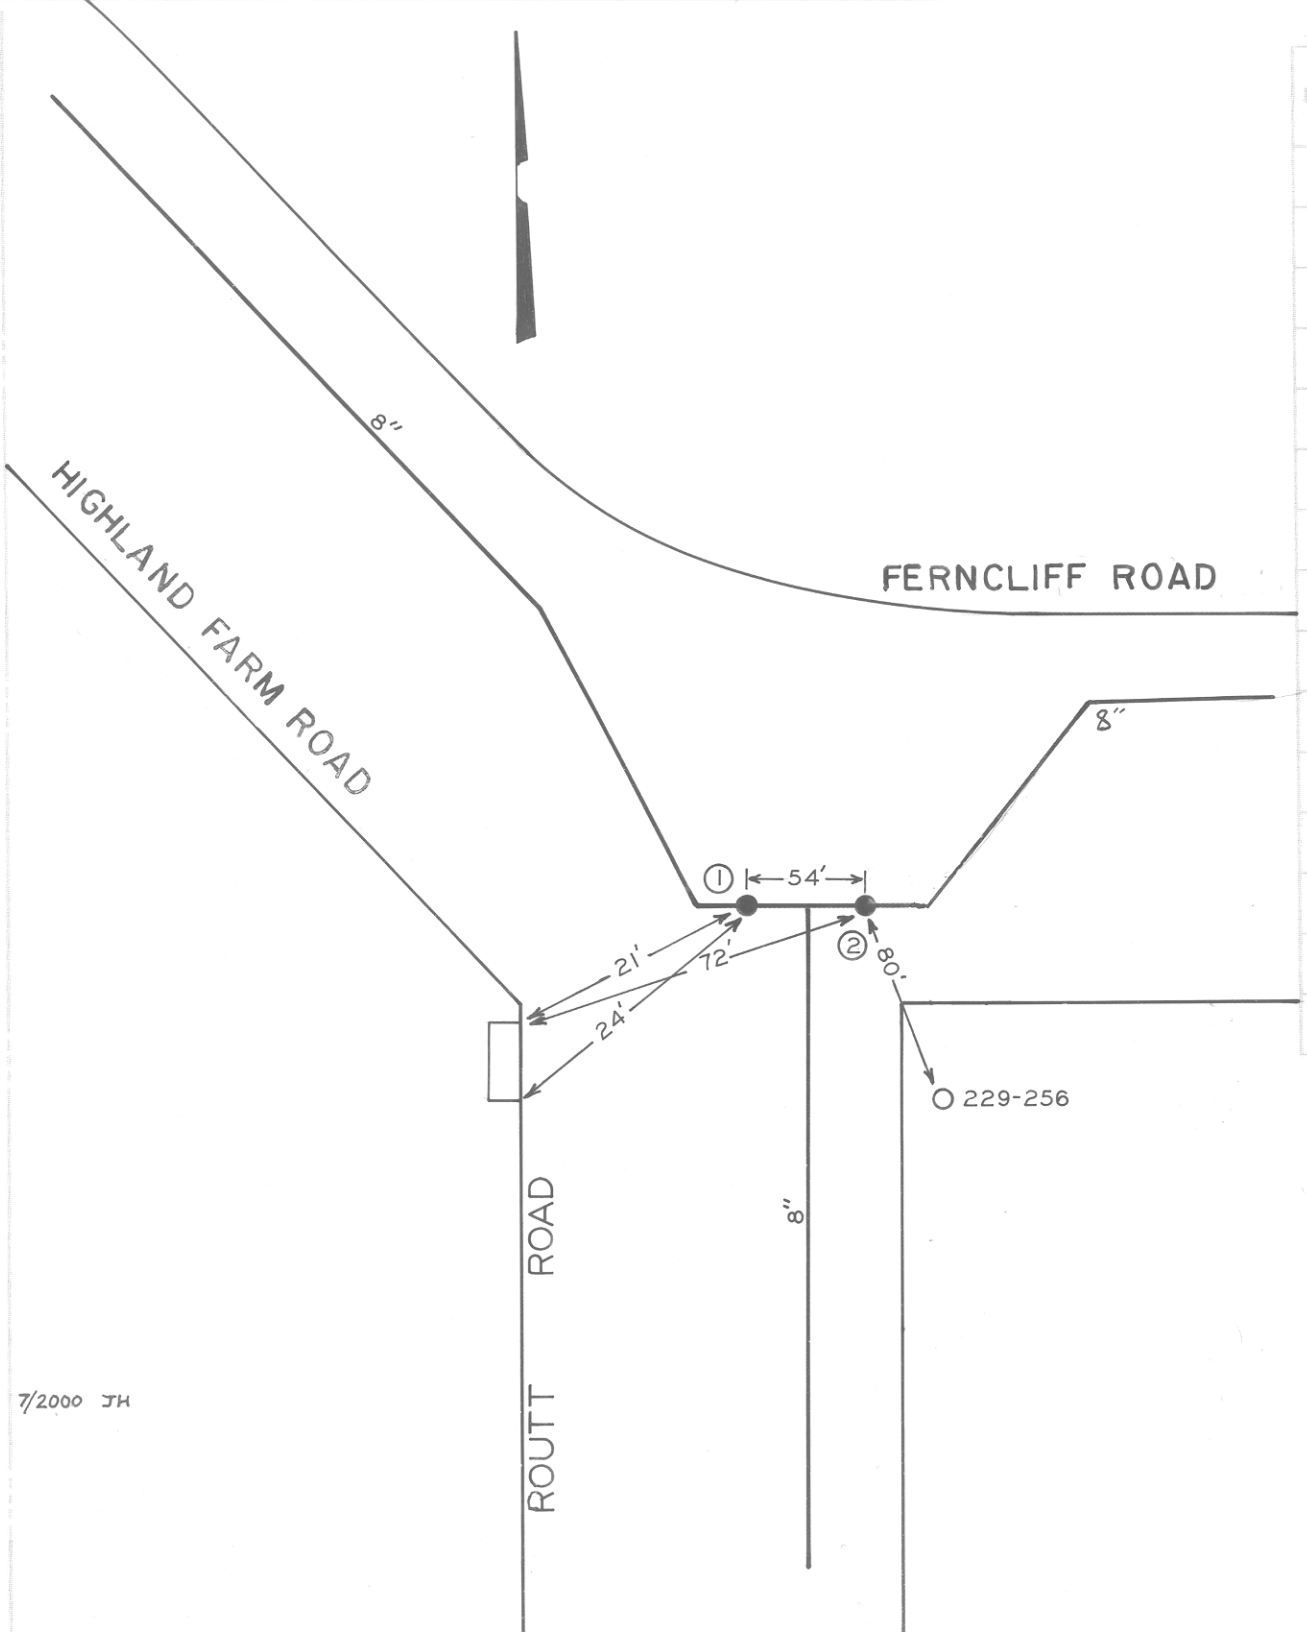

DATE	NO.	SIZE	MAKE	OPEN	TURNS
60	1	8"	DARLING	R	
60	2	8"	DARLING	R	

7/2000 JH

CITY OF ROANOKE—WATER DEP'T

VALVE DIAGRAM

HIGHLAND FARM ROAD &
ROUTT ROAD N.W.

SEC. MAP 644 , 646

DATE PAGE NO.