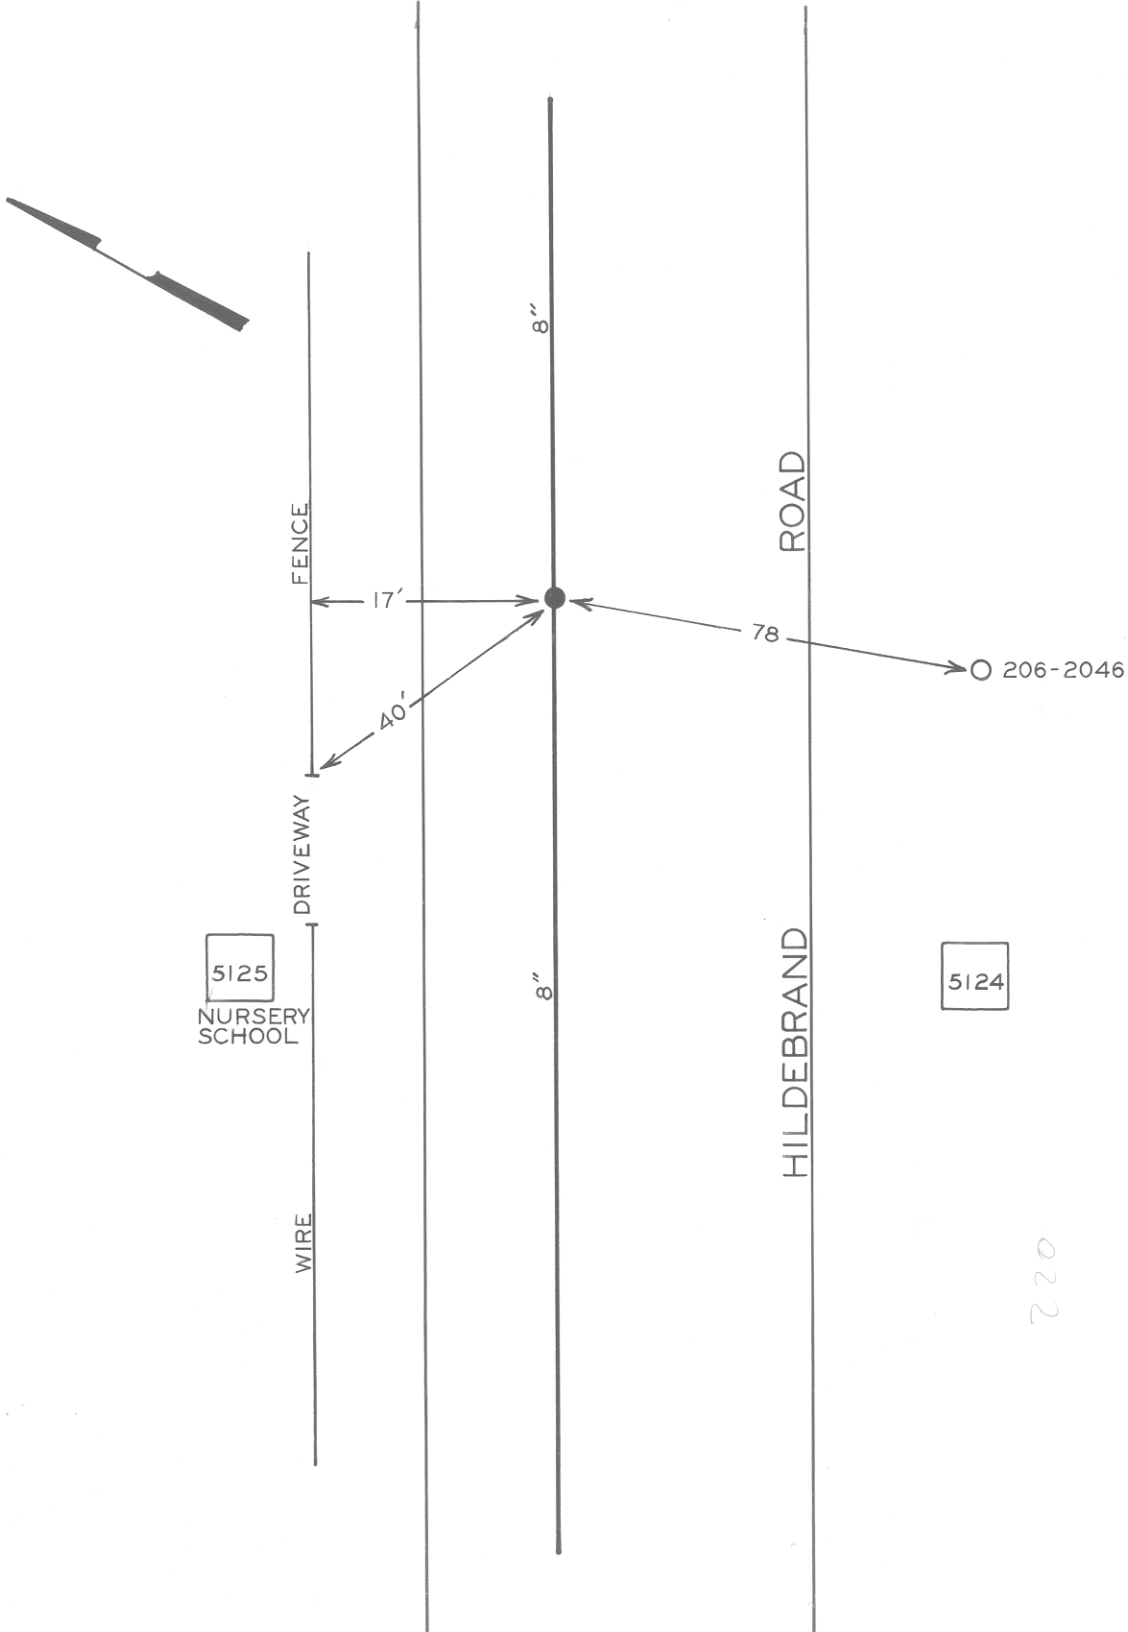


| DATE | NO. | SIZE | MAKE | OPEN | TURNS |
|---|---|---|---|---|---|
| 70 | 1 | 1" | PITOT STATION | | |

022

CITY OF ROANOKE—WATER DEP'T

VALVE DIAGRAM

5125 HILDEBRAND ROAD N.W.

SEC. MAP

DATE PAGE NO.