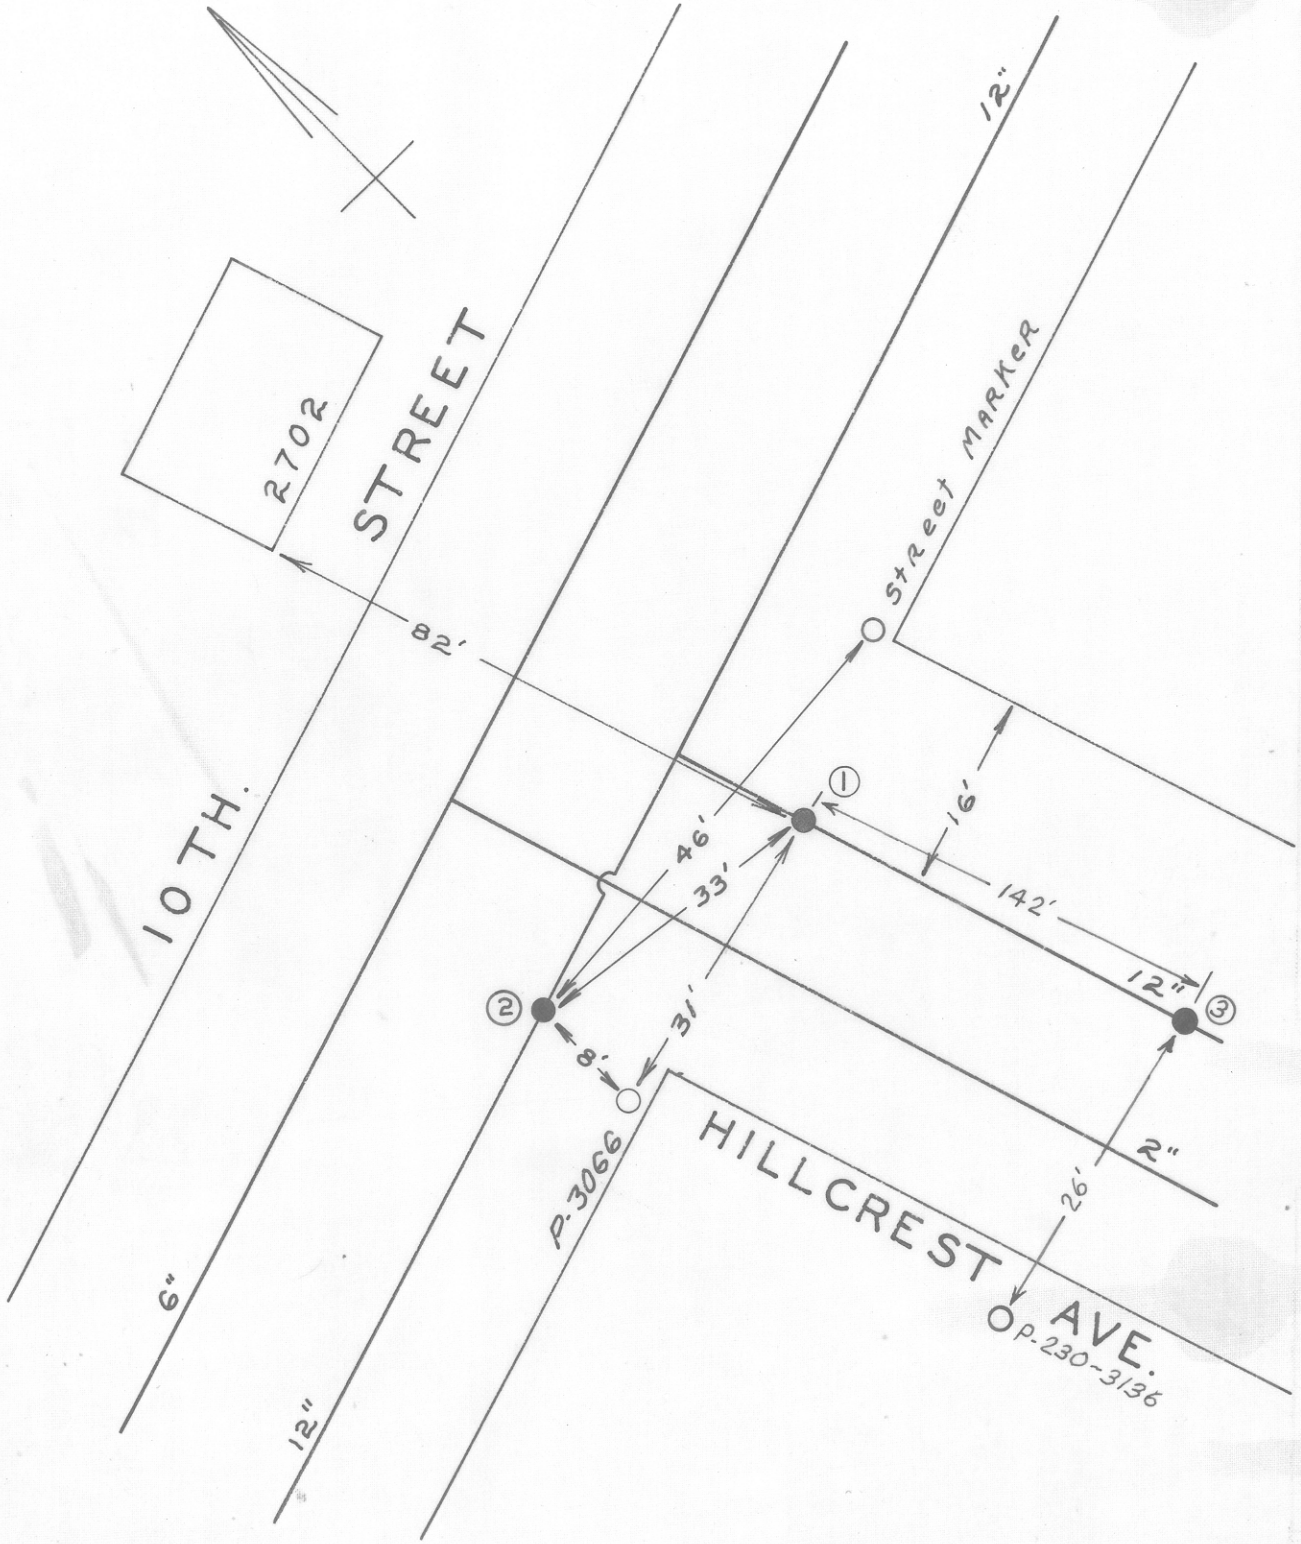

DATE	NO.	SIZE	MAKE	OPEN	TURNS
	1	12"	MUELLER	R	38
	2	12"	MUELLER	R	38
4-68	3	1"	PITOT STATION		
	1	0	SPL		
	2	0	WPL		

CITY OF ROANOKE — WATER DEPT.

VALVE DIAGRAM

HILLCREST AVE. & 10TH. STREET N.W.

EAST INTERSECTION

SEC. MAP 207

DATE PAGE NO.

"IMPERIAL" TRACING CLOTH
K & E CO., N.Y.