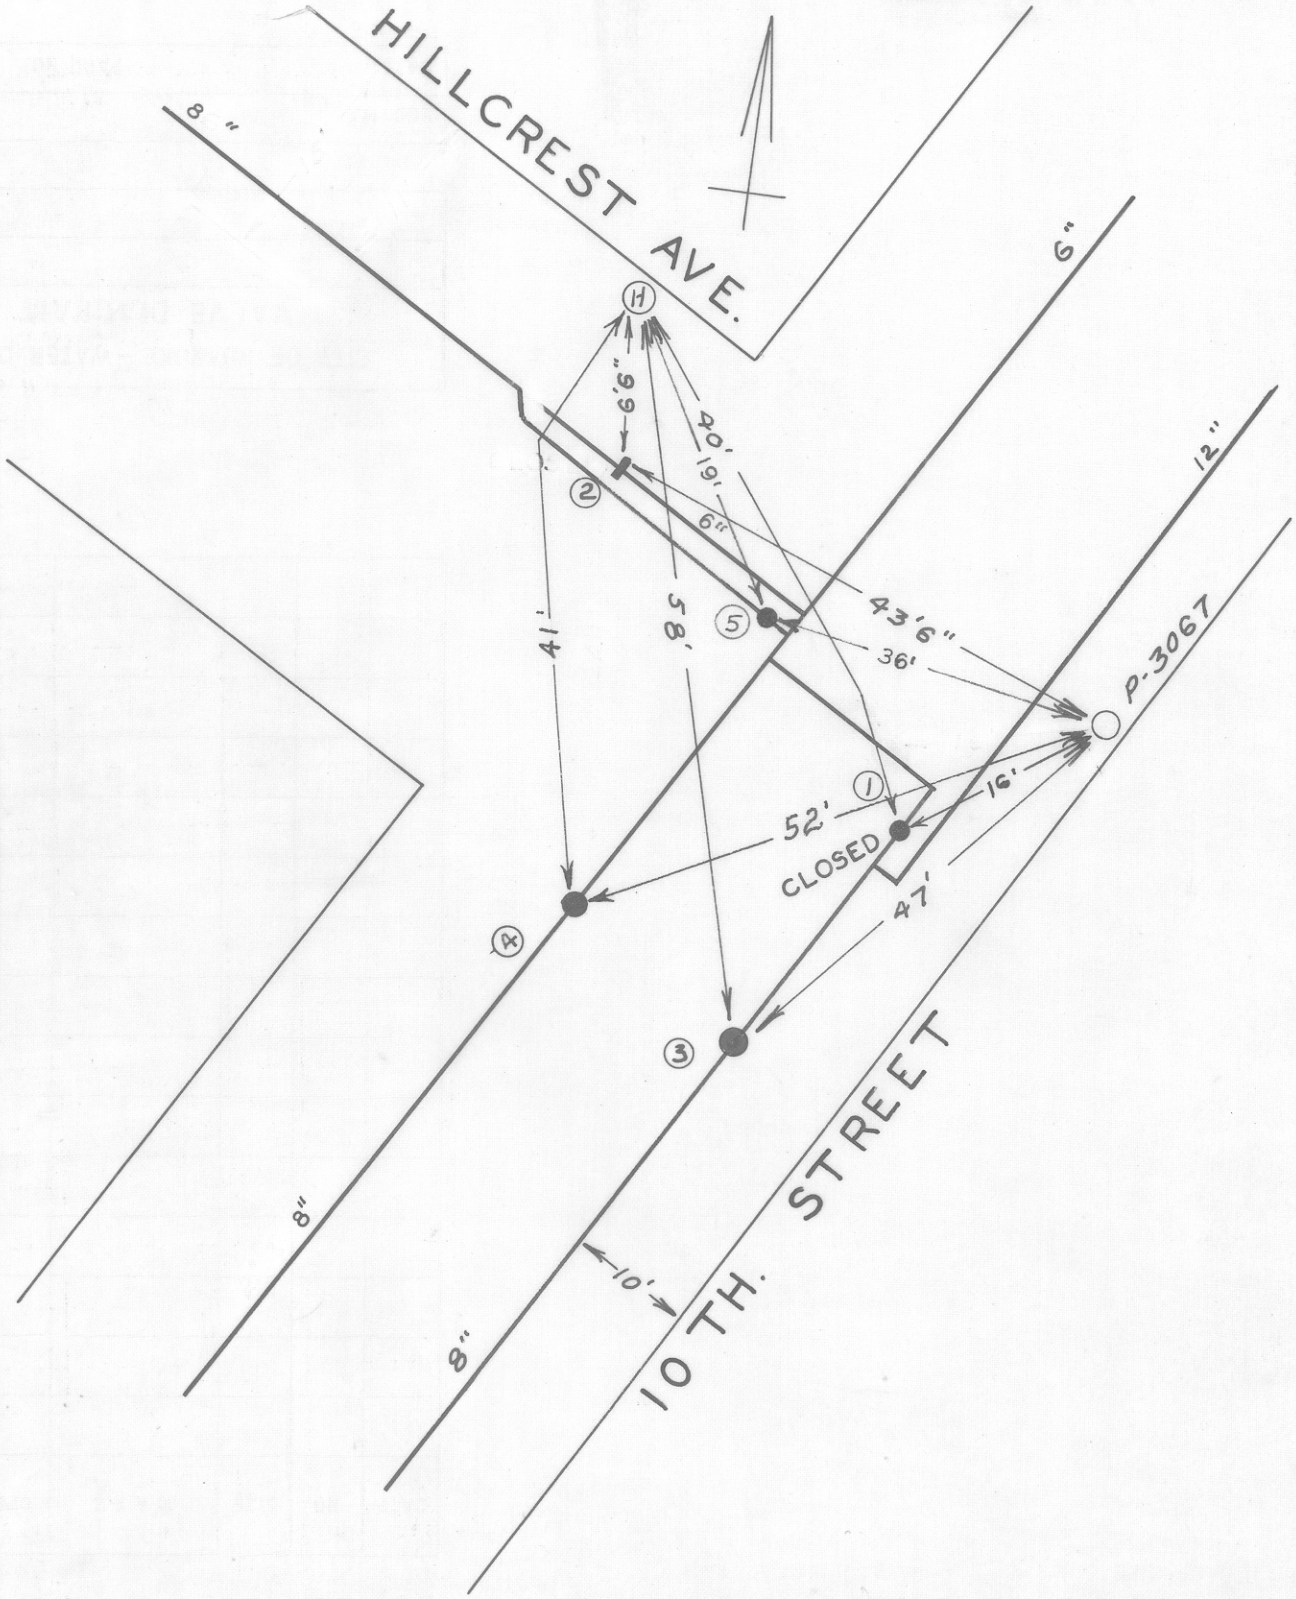

DATE	NO.	SIZE	MAKE	OPEN	TURNS
	1	6"			
	2	6"			
	3	8"		R	26½
11-61	4	8"	DARLING	R	
4-67	5	8"	MUELLER	R	
	1	14'-W	EPL		
	2	3'-W	WPL		
	3	0	SPL		
	4	0	WPL		
	5	8'S	N.P.L.		

CITY OF ROANOKE—WATER DEPT.

VALVE DIAGRAM

HILLCREST AVE. & 10TH. STREET N. W.

WEST INTERSECTION

SEC. MAP 207

DATE PAGE NO.

"IMPERIAL" TRACING CLOTH. K & E CO., N. Y.