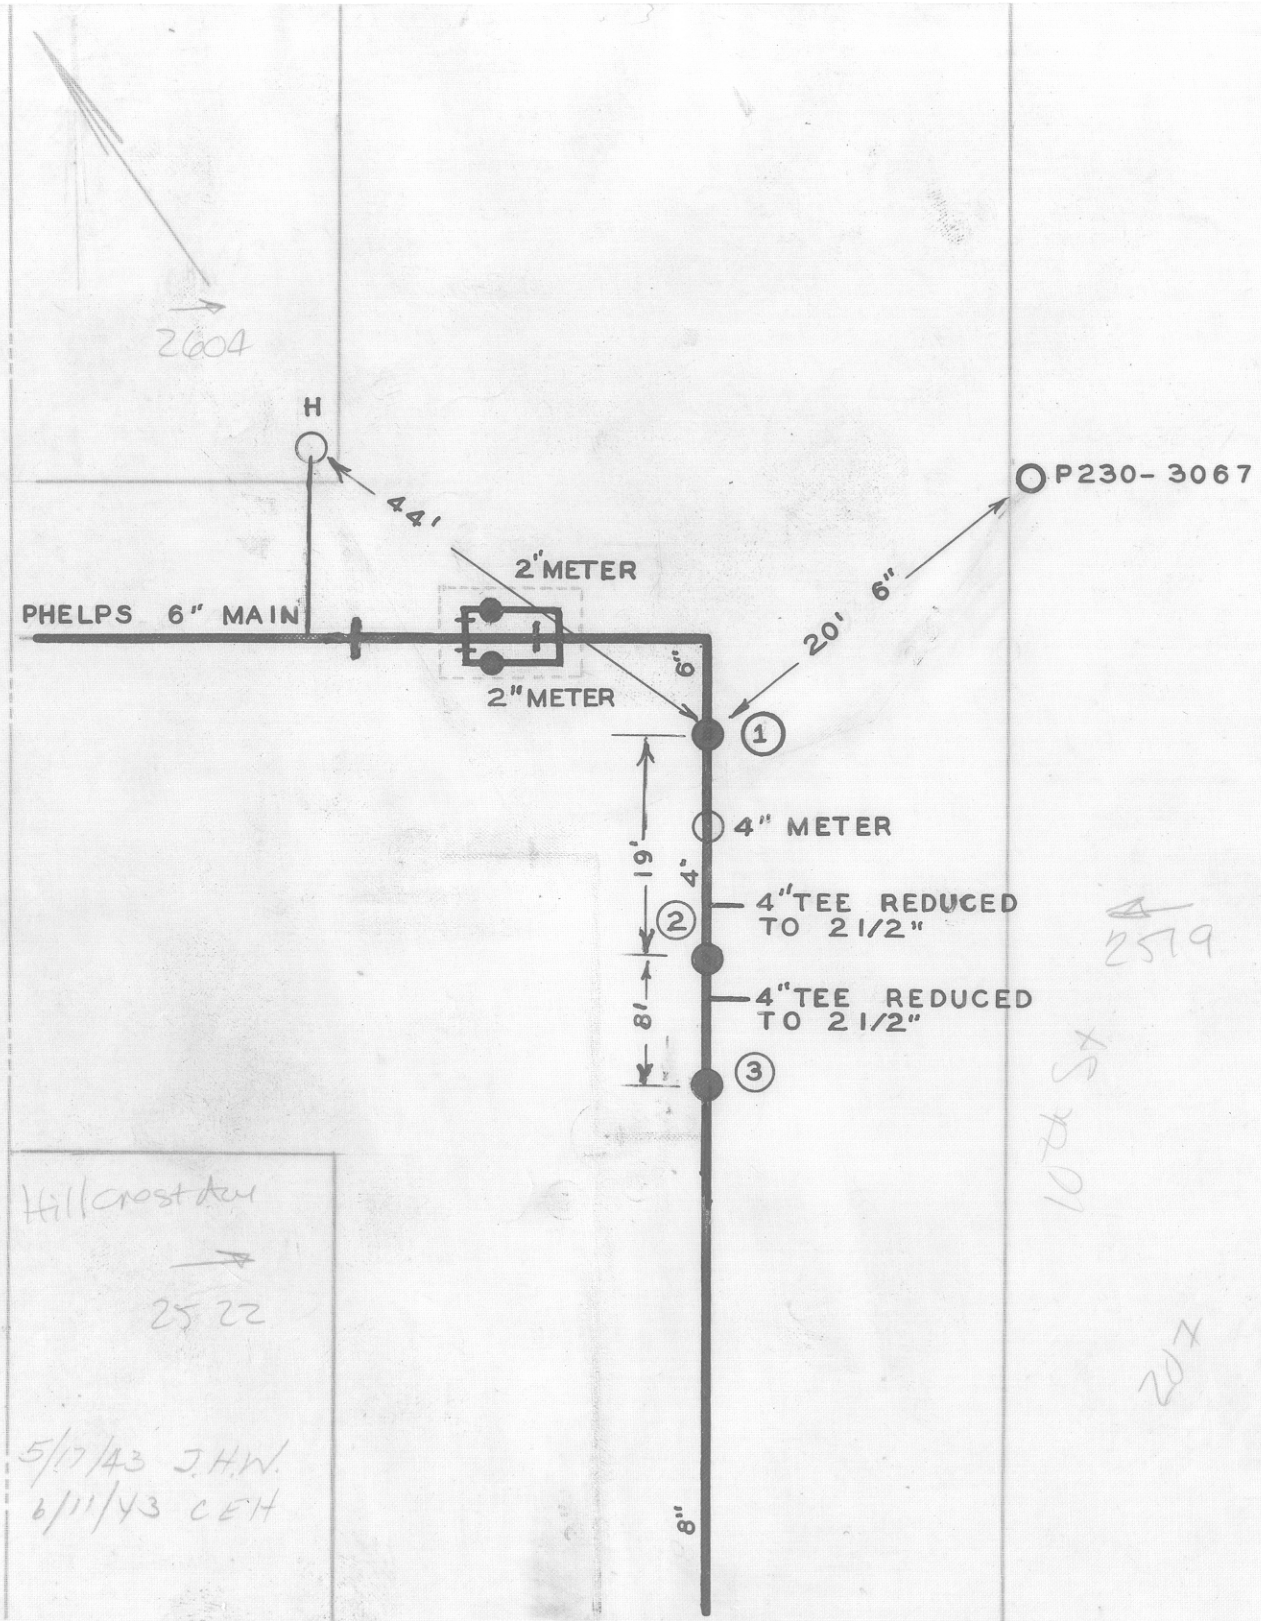

DATE	NO.	SIZE	MAKE	OPEN	TURNS
1942	~~1~~	~~6"~~	out	R	20 1/2
1942	~~2~~	~~4"~~	out	R	9 1/2
1942	3	8"		R	26 1/2
1942	~~4~~	~~2"~~	out	R	7
1942	~~5~~	~~2"~~	out	R	7
1942	~~6~~	~~2"~~	~~KEEP CLOSED~~ out		

2519

10th St

20th

CITY OF ROANOKE—WATER DEP'T

VALVE DIAGRAM

HILL CREST AVE. & 10TH. ST. N.W.

SEC. MAP S-12

DATE

PAGE NO. N.W. 80