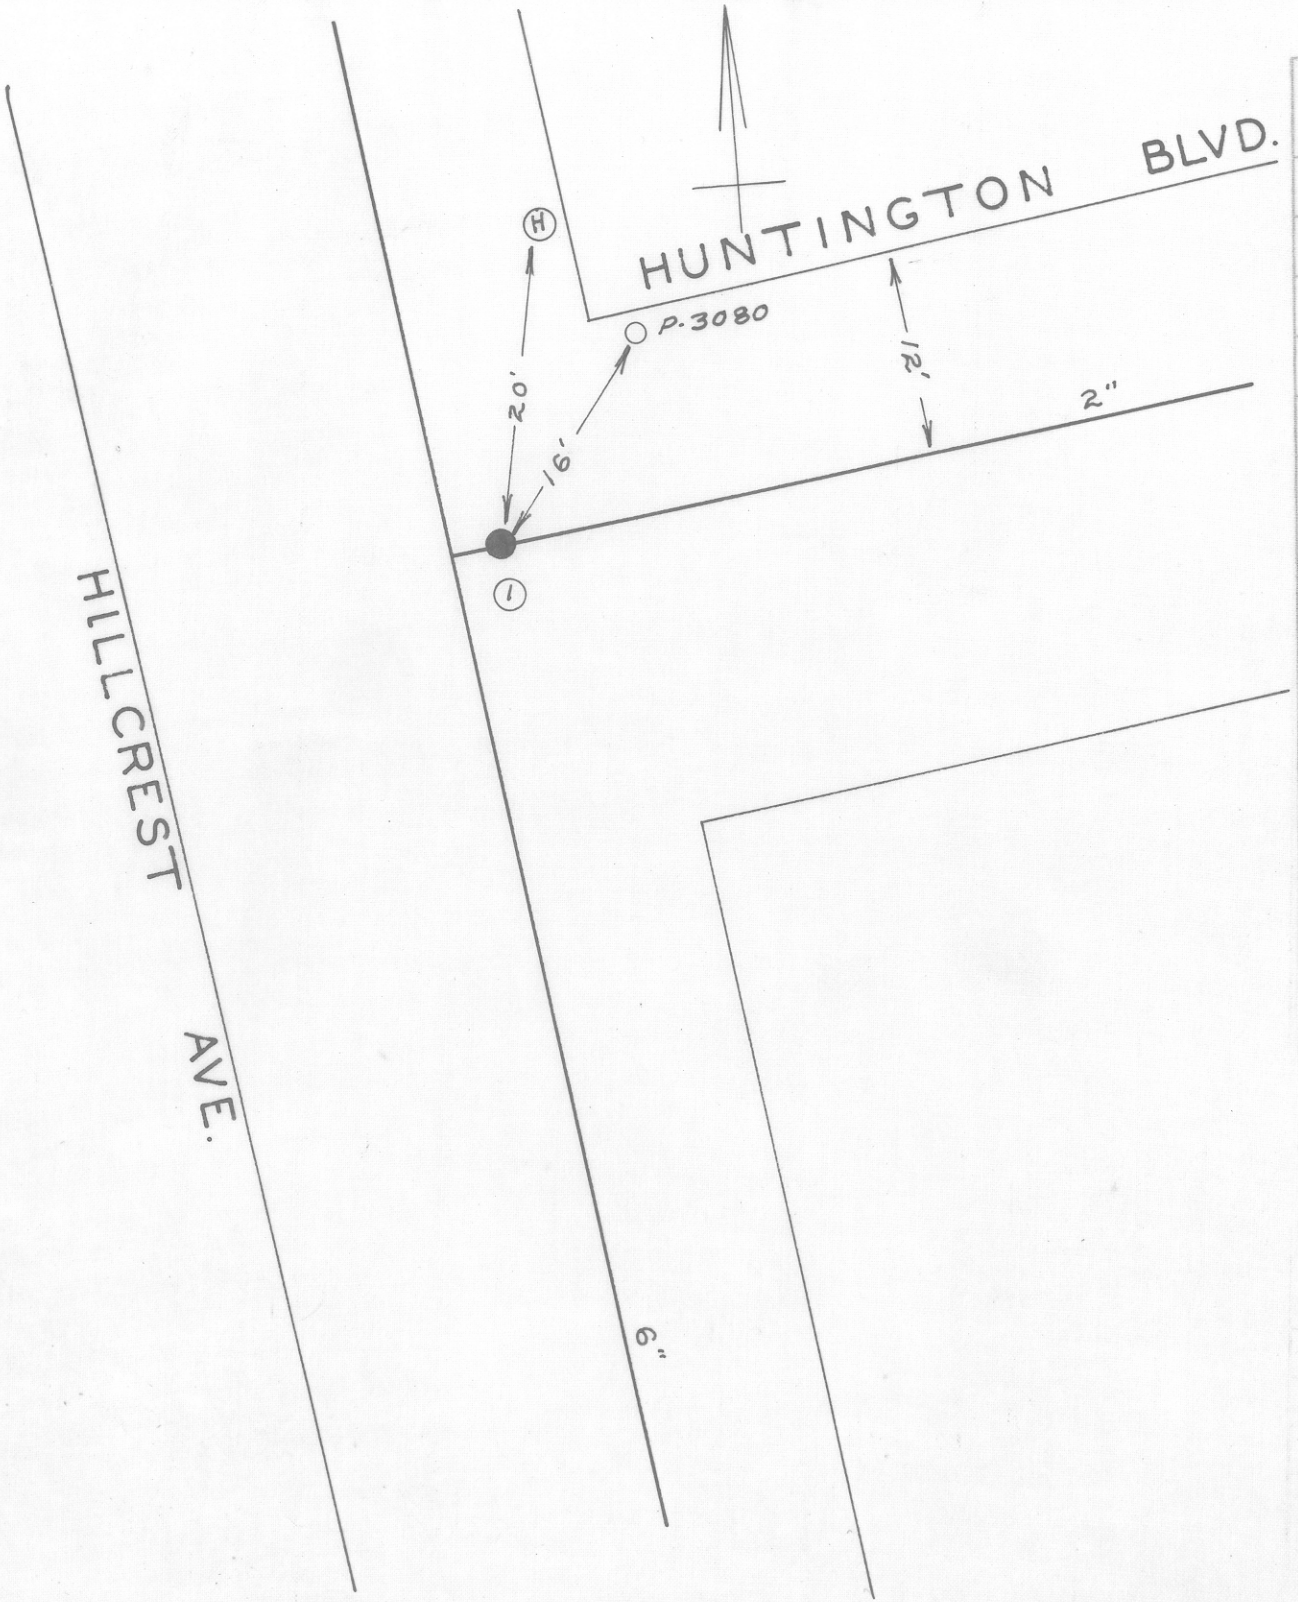

DATE	NO.	SIZE	MAKE	OPEN	TURNS
	1	2"			
	1	14-W	EPL		

CITY OF ROANOKE—WATER DEPT.

VALVE DIAGRAM

HILLCREST AVE. &

HUNTINGTON BLVD. N.W.

SEC. MAP 215

DATE PAGE NO.

"IMPERIAL" TRACING CLOTH
K & E CO., N. Y.