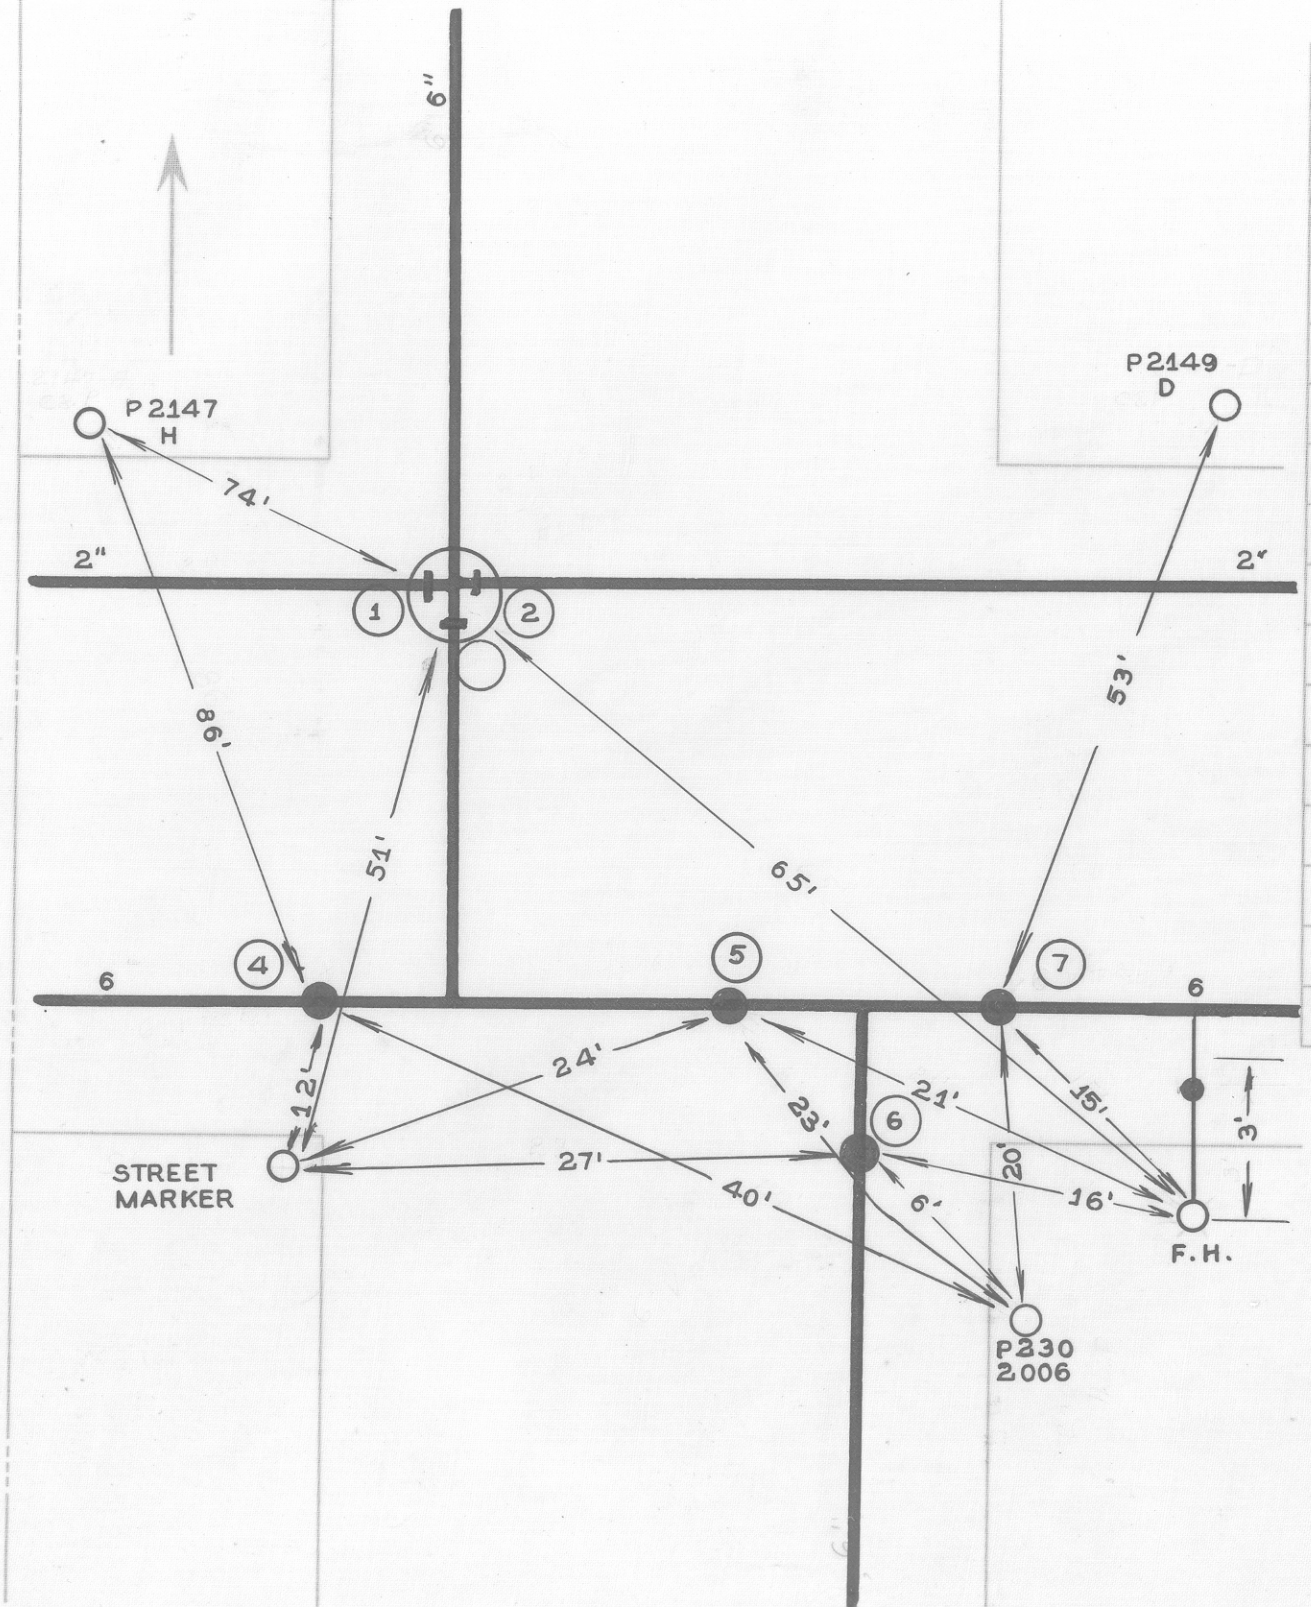

DATE	NO.	SIZE	MAKE	OPEN	TURNS
	1	2"			
	2	2"			
	3	6"			
	4	6"			
	5	6"			
	6	6"			
	7	6"			

CITY OF ROANOKE—WATER DEP'T

VALVE DIAGRAM

HILLCREST AVENUE &

OAKLAND BOULEVARD N.W.

SEC. MAP 215

DATE W.R. PAGE NO N.W.405