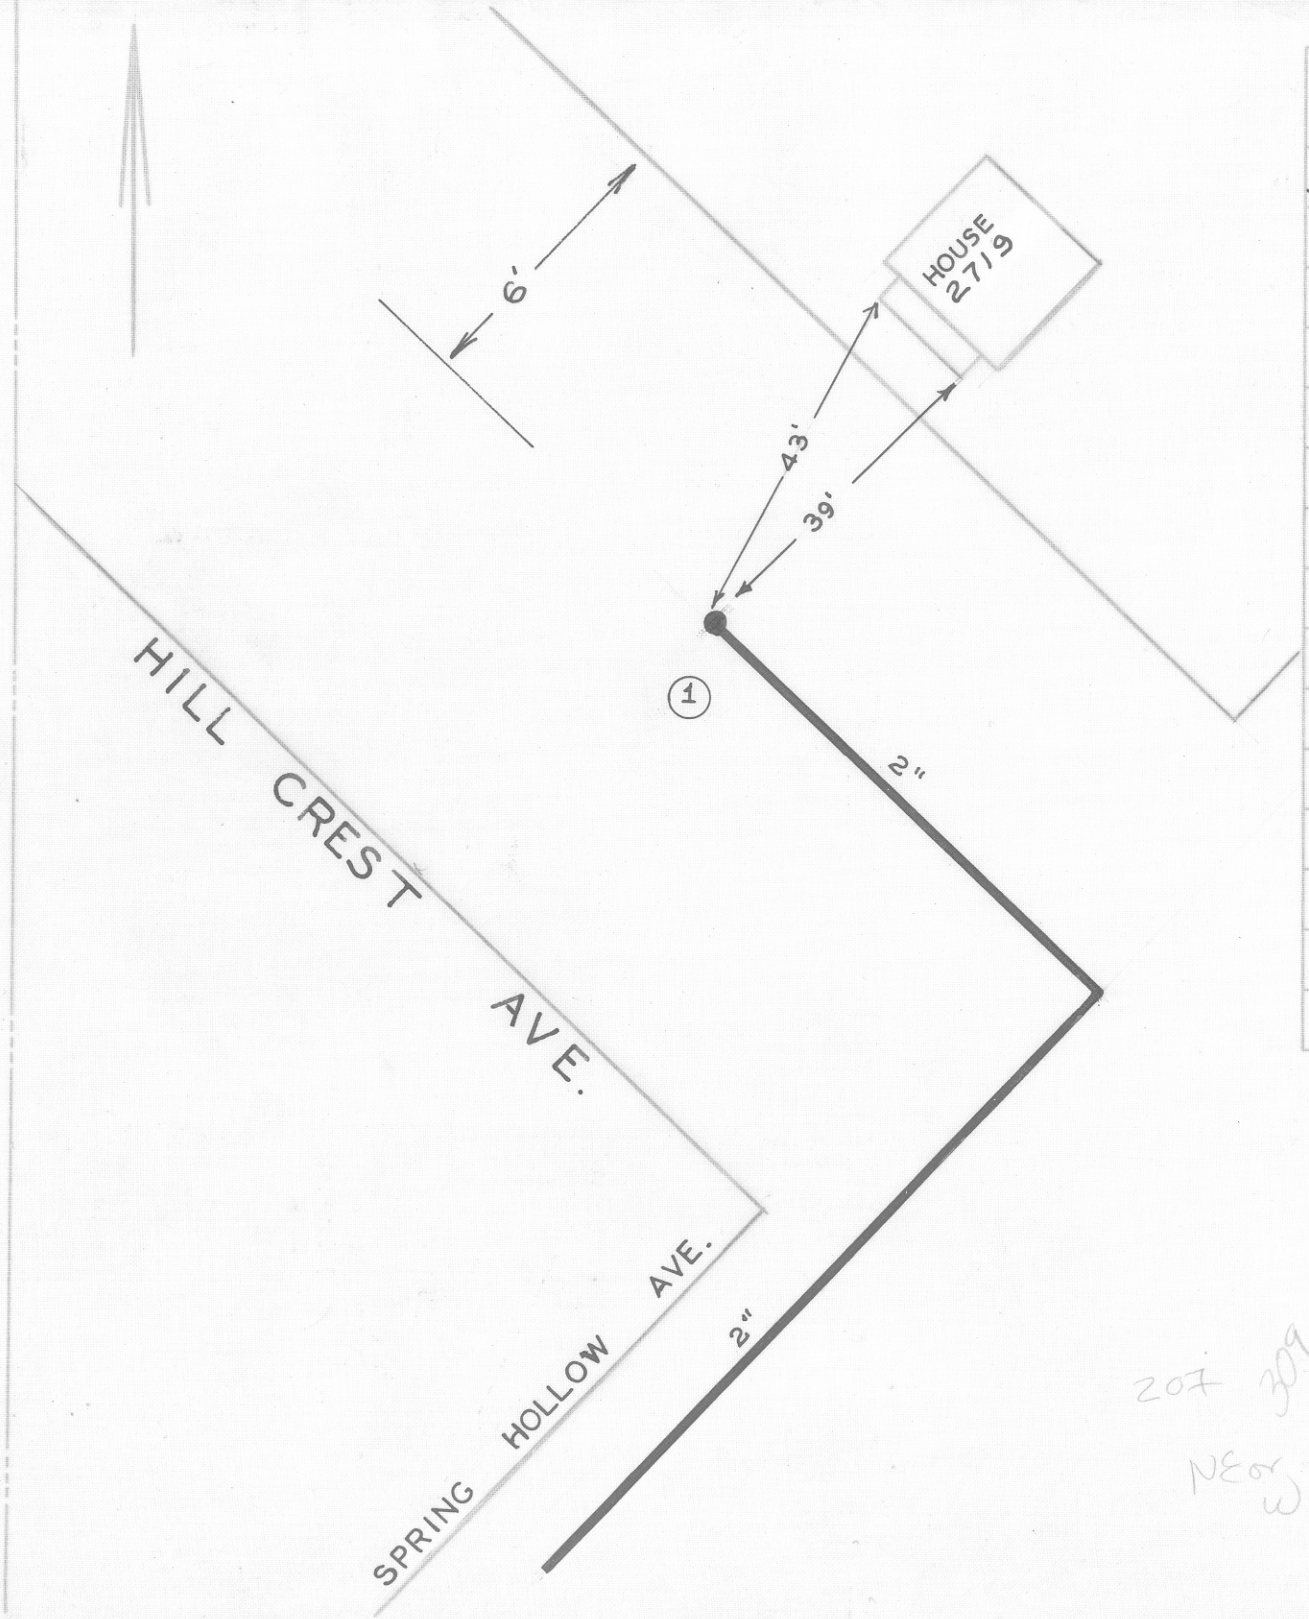


| DATE | NO. | SIZE | MAKE | OPEN | TURNS |
|---|---|---|---|---|---|
| 1948 | 1 | 2" | DARLING | R | 7 |
| | | | | | |
| | | | | | |
| | 1 | 230'-N | NPL | SPRING HOLLOW | |
| | | | | | |

CITY OF ROANOKE—WATER DEP'T

VALVE DIAGRAM

2719 HILL CREST AVENUE N.W.

SEC. MAP S-11

DATE 3/15/48 PAGE NO. N.W.309

207 309

NE or W