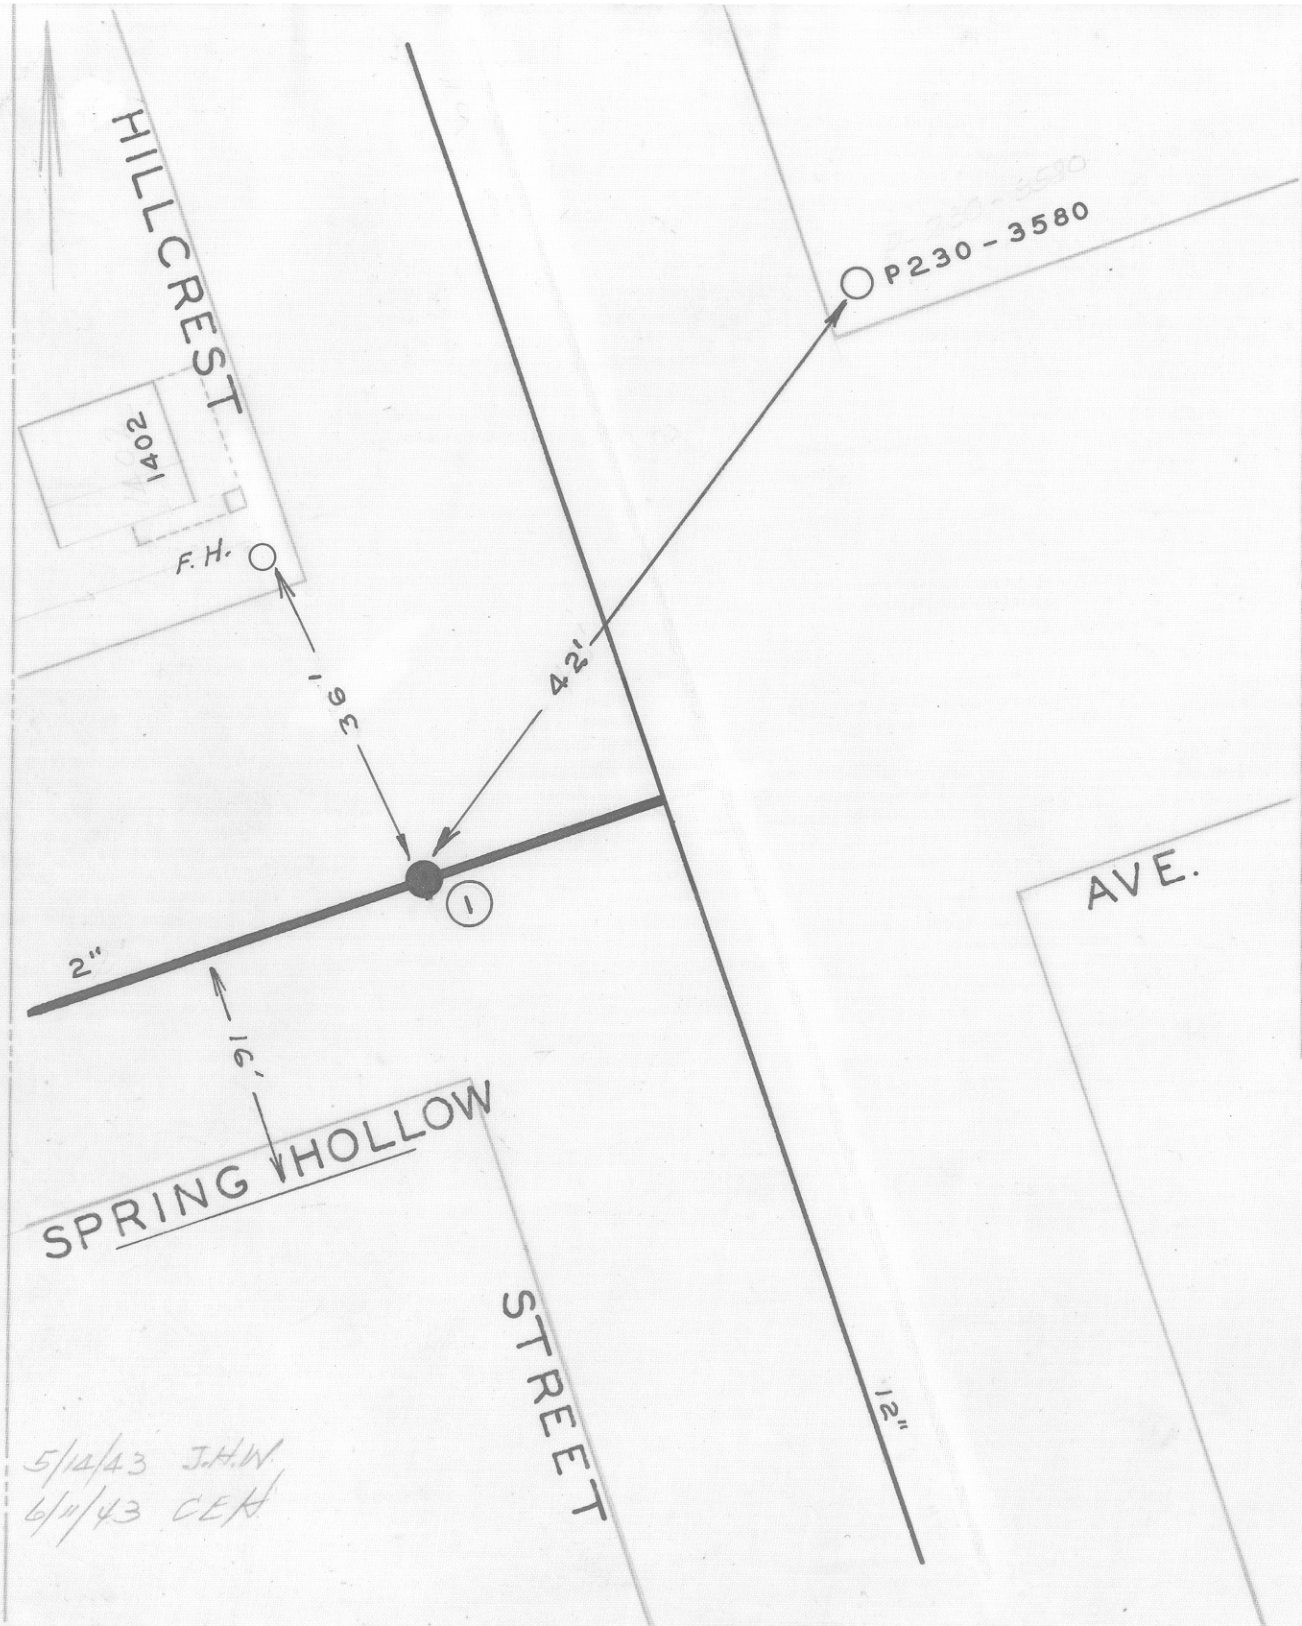

DATE	NO.	SIZE	MAKE	OPEN	TURNS
1929	1	2"		L	8 1/2
	1	5'E	WPL		

5/12/43 J.H.W.
6/11/43 CEH

CITY OF ROANOKE—WATER DEP'T
VALVE DIAGRAM
HILL CREST ST. & SPRING HOLLOW AVE. N. W.

SEC. MAP 207

DATE PAGE NO. N.W.277.