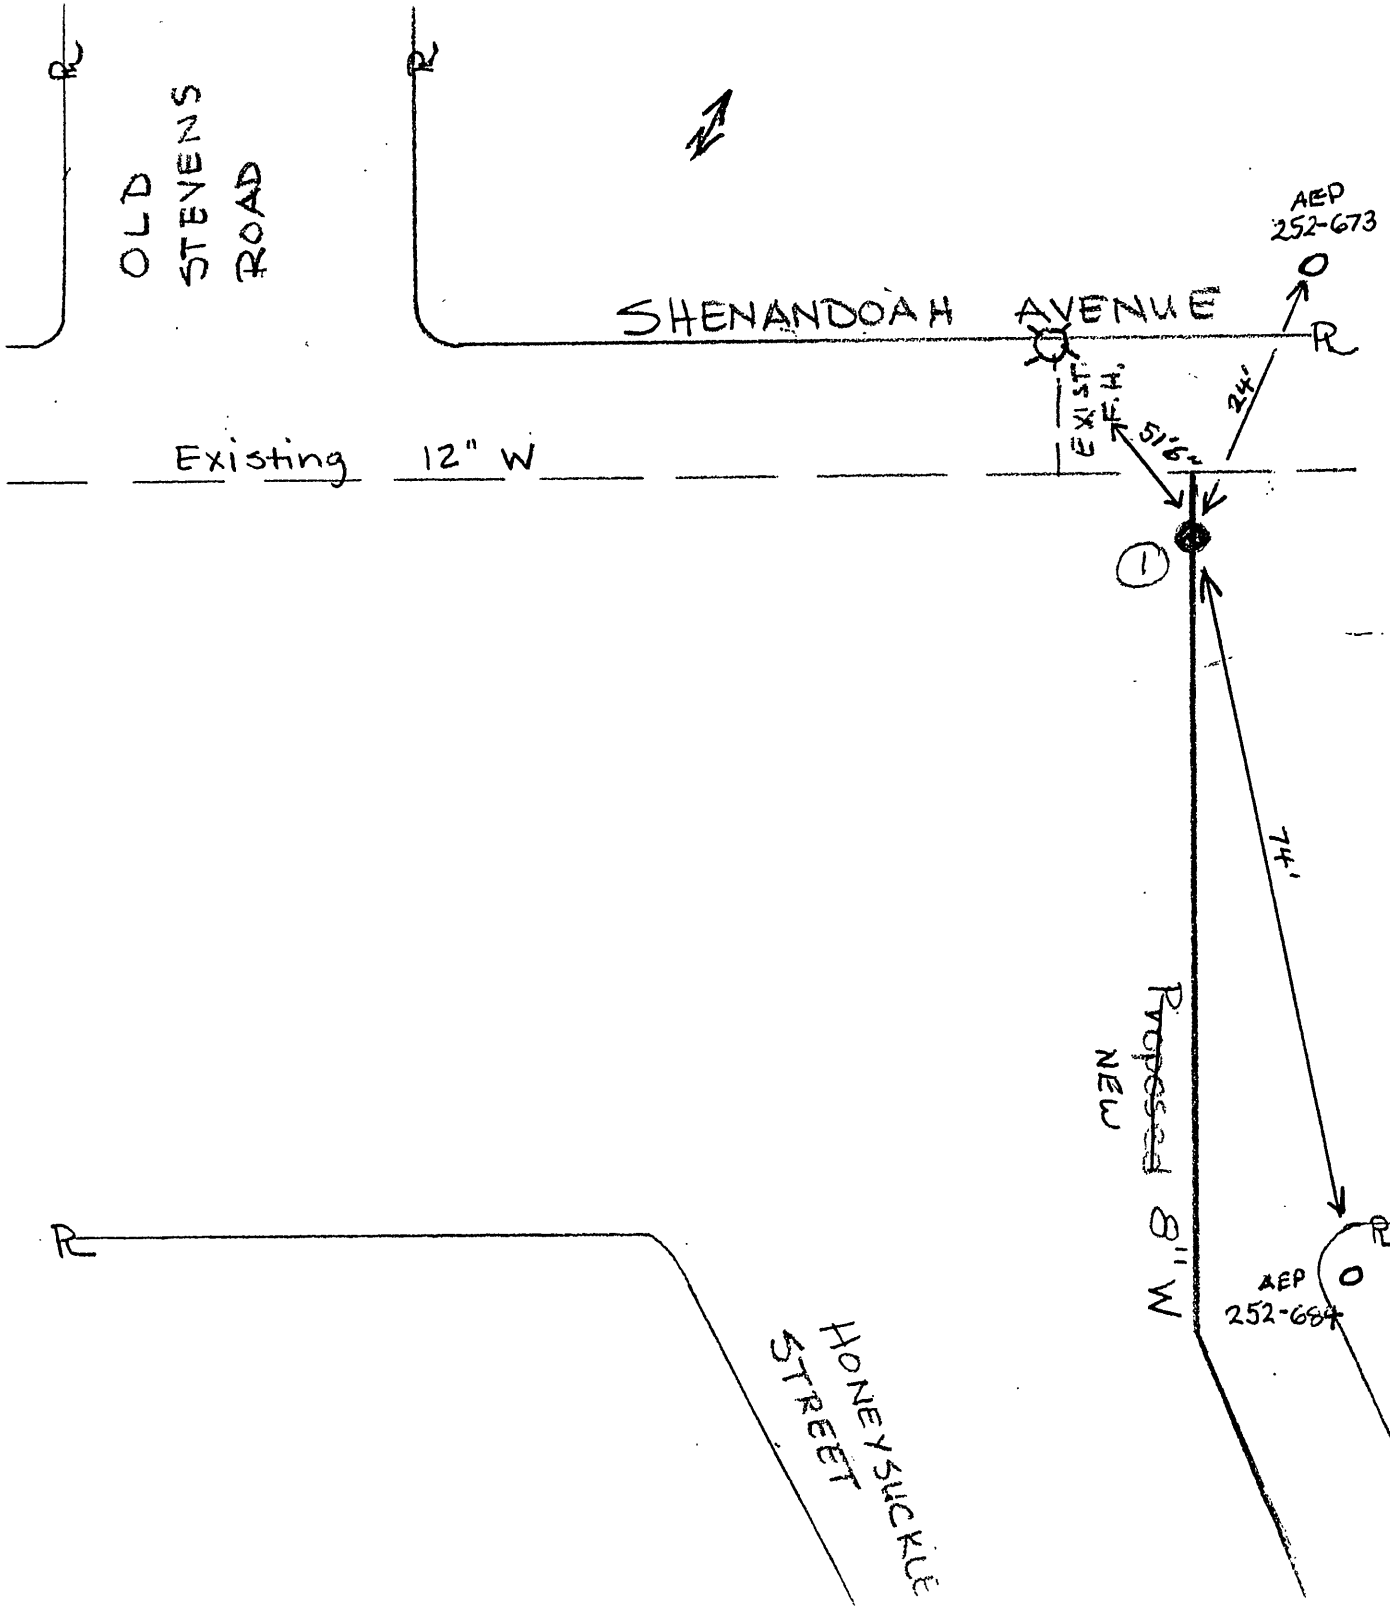

DATE	NO.	SIZE	MAKE	OPEN	TURNS
3/01	1	8"	AWWA	R	27

P. L. Measurements		
No.	Distance	Direction

CITY OF ROANOKE - WATER DEPT.

VALVE DIAGRAM

HONEYSUCKLE STREET

SHENANDOAH AVENUE

Sec. Map 263, 272 N.W.

Date 3-7-01 Page No.