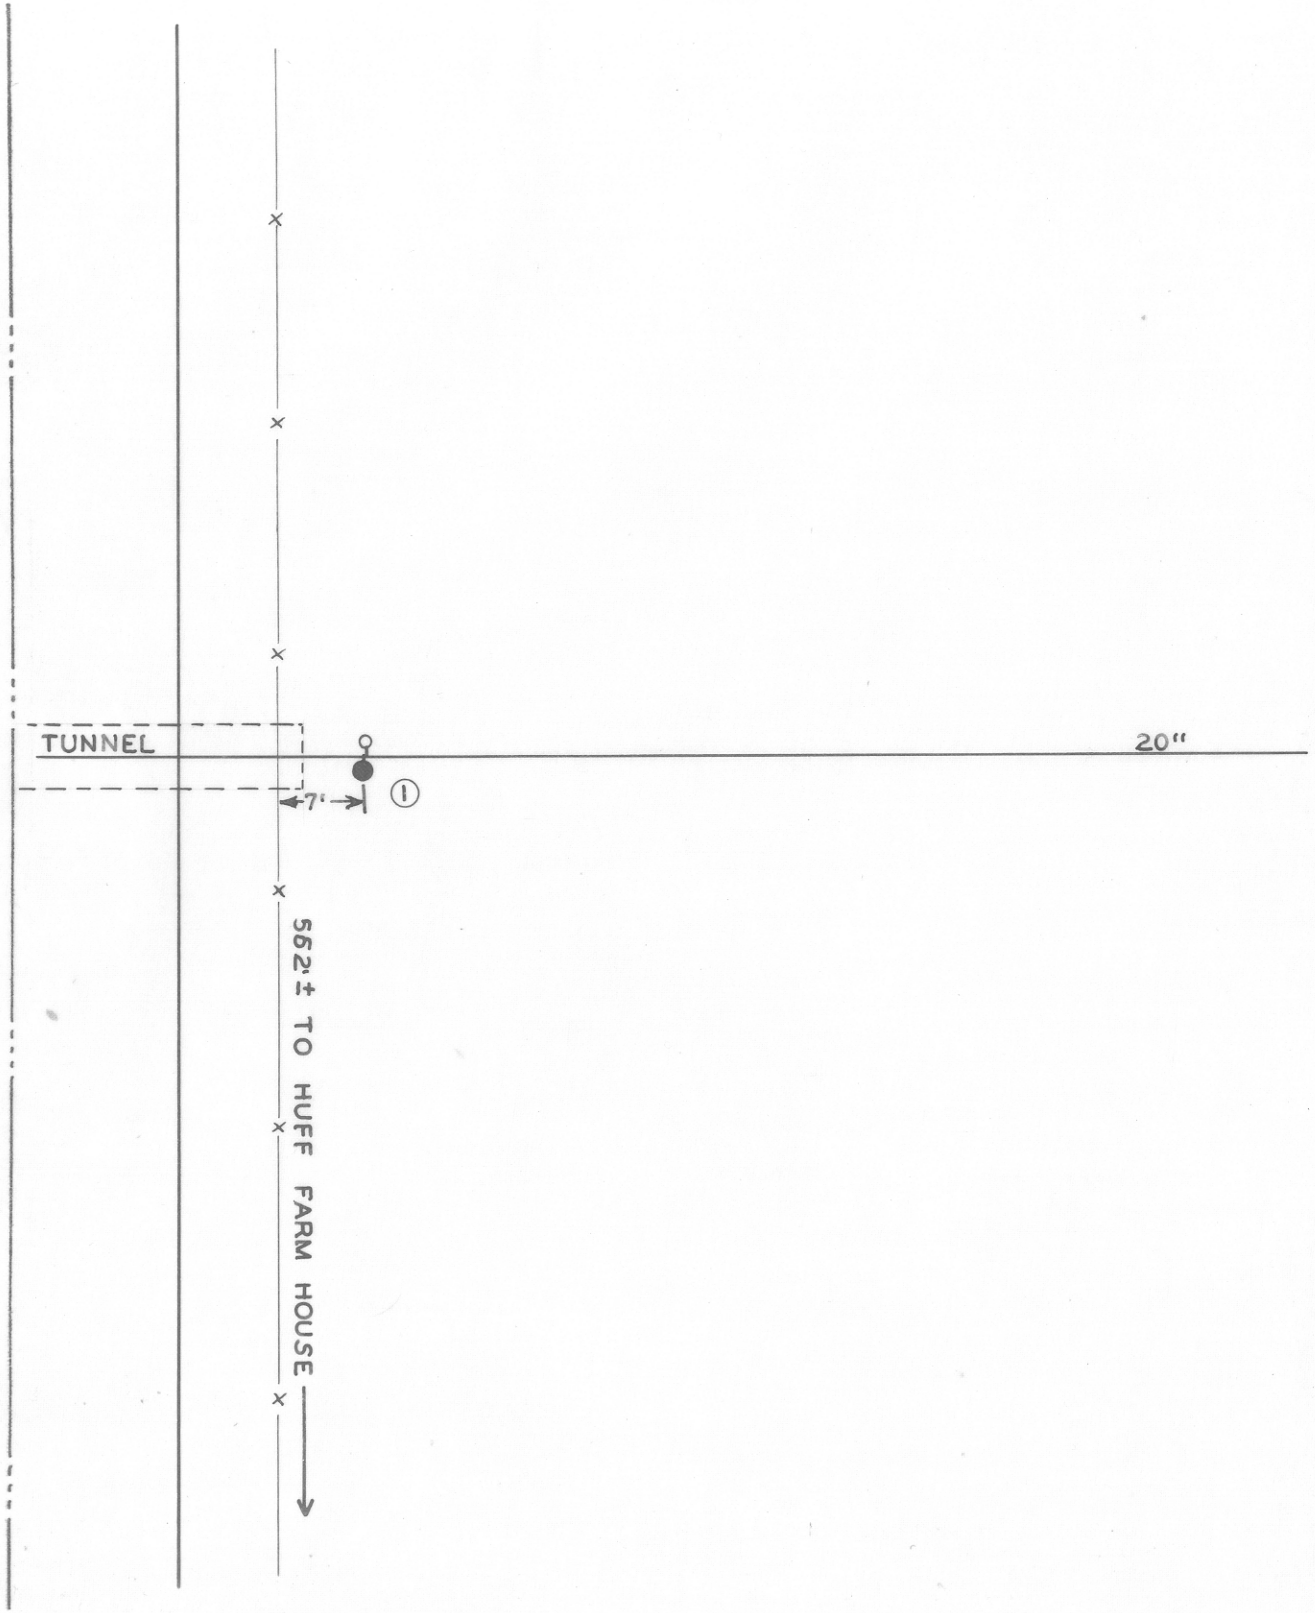

DATE	NO.	SIZE	MAKE	OPEN	TURNS
12-64	1	20"	DARLING	R	63

CITY OF ROANOKE — WATER DEPT.

VALVE DIAGRAM

HUFF FARM AT TUNNEL

UNDER 581 N.W.

SEC. MAP 249

DATE PAGE NO.