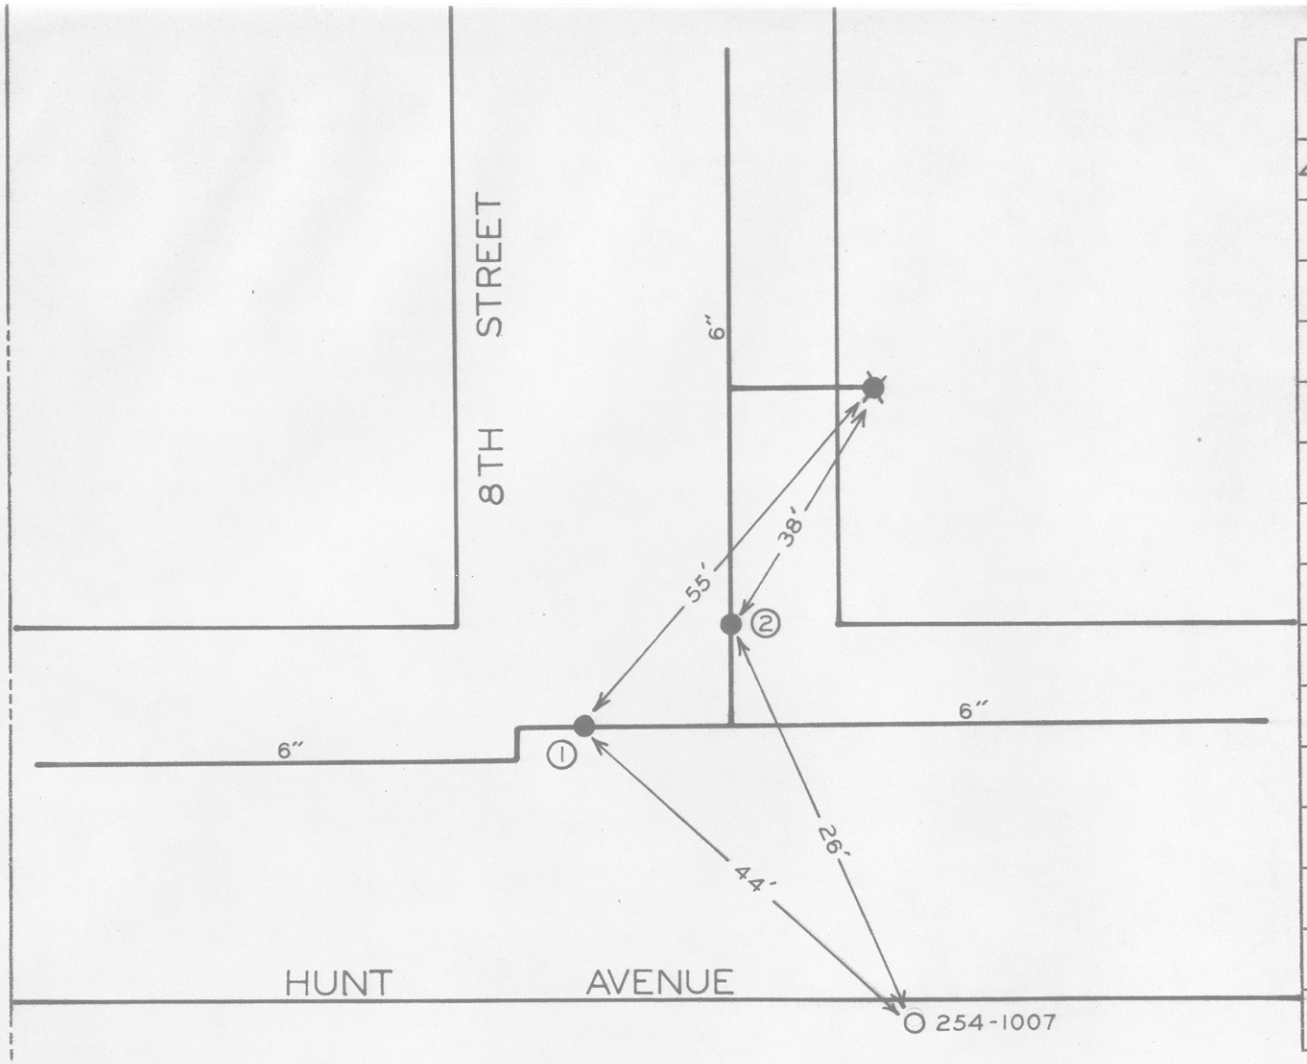

DATE	NO.	SIZE	MAKE	OPEN	TURNS
4-68	1	6"	DARLING	R	
69	2	6"	MUELLER	R	

CITY OF ROANOKE—WATER DEP'T

VALVE DIAGRAM

HUNT AVENUE & 8TH STREET N.W

SEC. MAP

DATE PAGE NO.