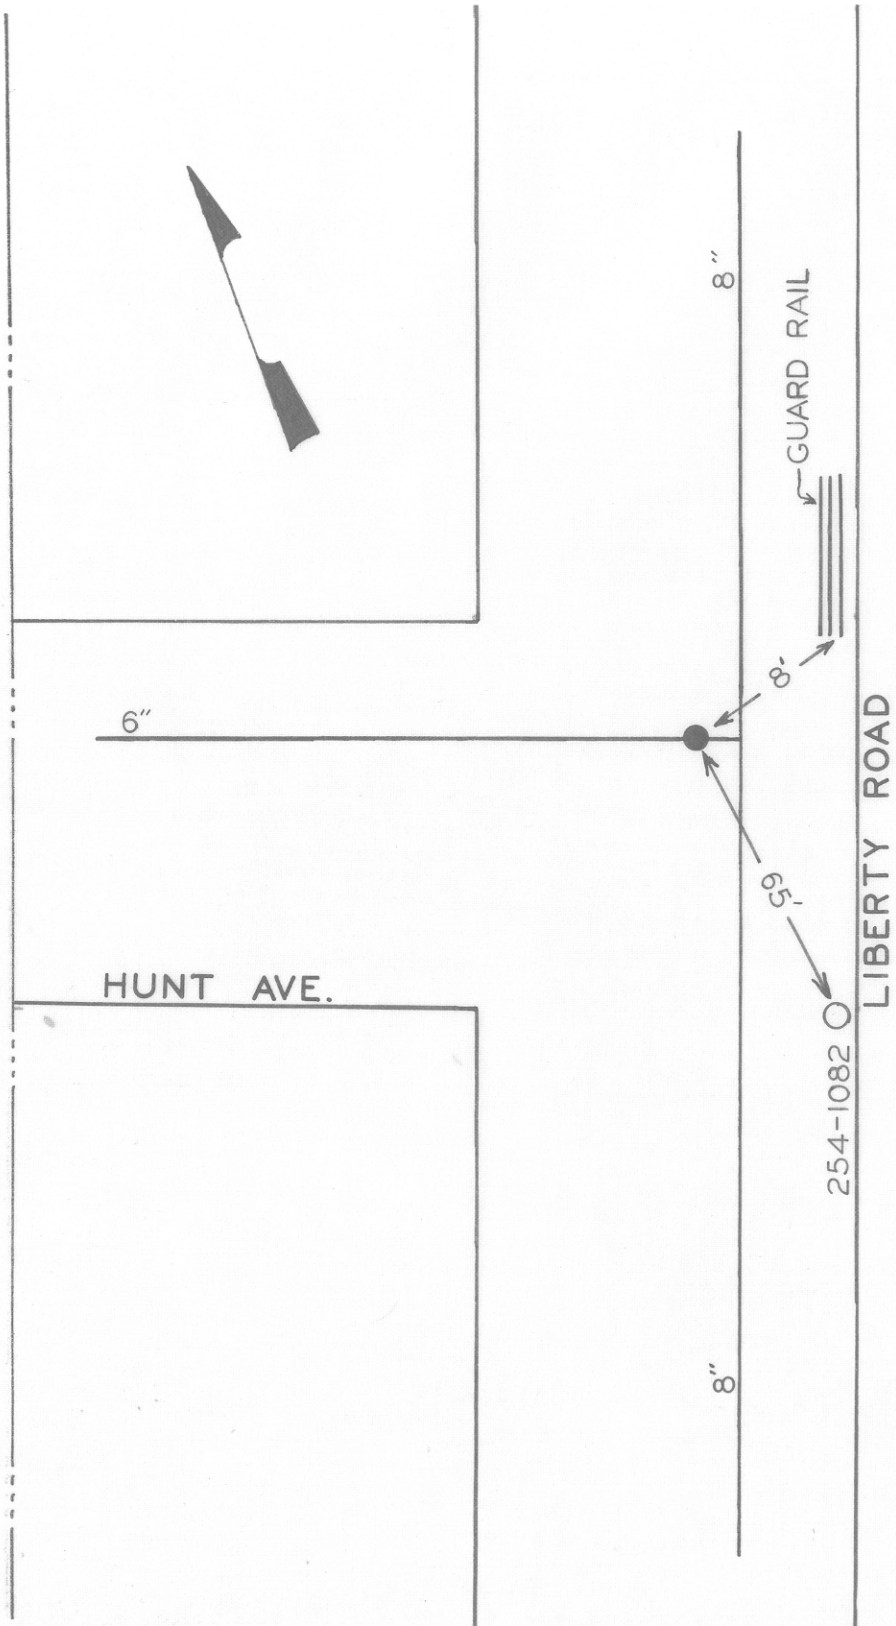

DATE	NO.	SIZE	MAKE	OPEN	TURNS
4-68	1	6"	DARLING	R	

CITY OF ROANOKE — WATER DEPT.

VALVE DIAGRAM

HUNT AVE. & LIBERTY RD. N.W.

SEC. MAP 205

DATE PAGE NO.