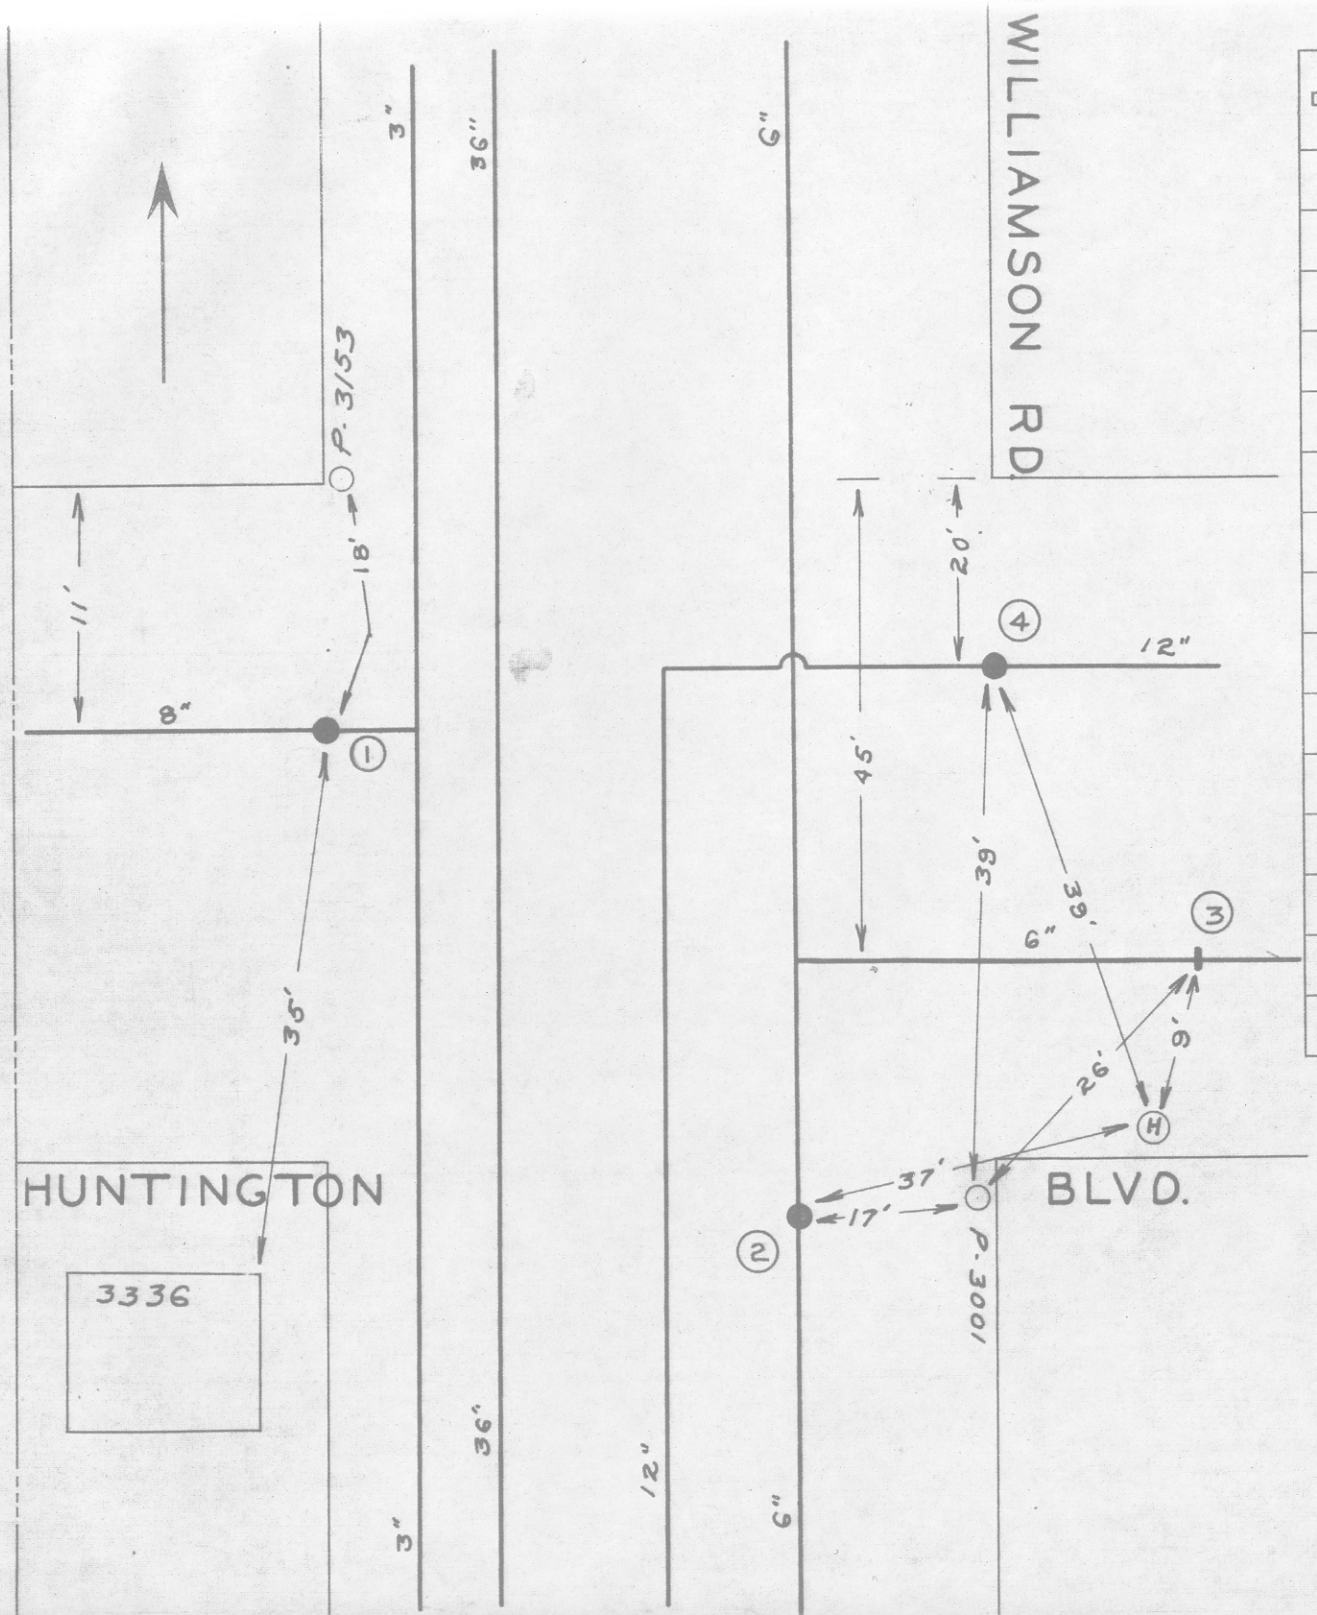

DATE	NO.	SIZE	MAKE	OPEN	TURNS
	1	8"	MUELLER	R	27
	2	6"			
	3	6"			
	4	12"	MUELLER	R	38
	1	0	WPL		
	2	8'-S	SPL		
	3	27'-E	EPL		
	4	0	EPL		

CITY OF ROANOKE—WATER DEP'T

VALVE DIAGRAM

HUNTINGTON BLVD. &

WILLIAMSON RD. N. W. OR

N. E. copy

SEC. MAP 208-317

DATE PAGE NO.