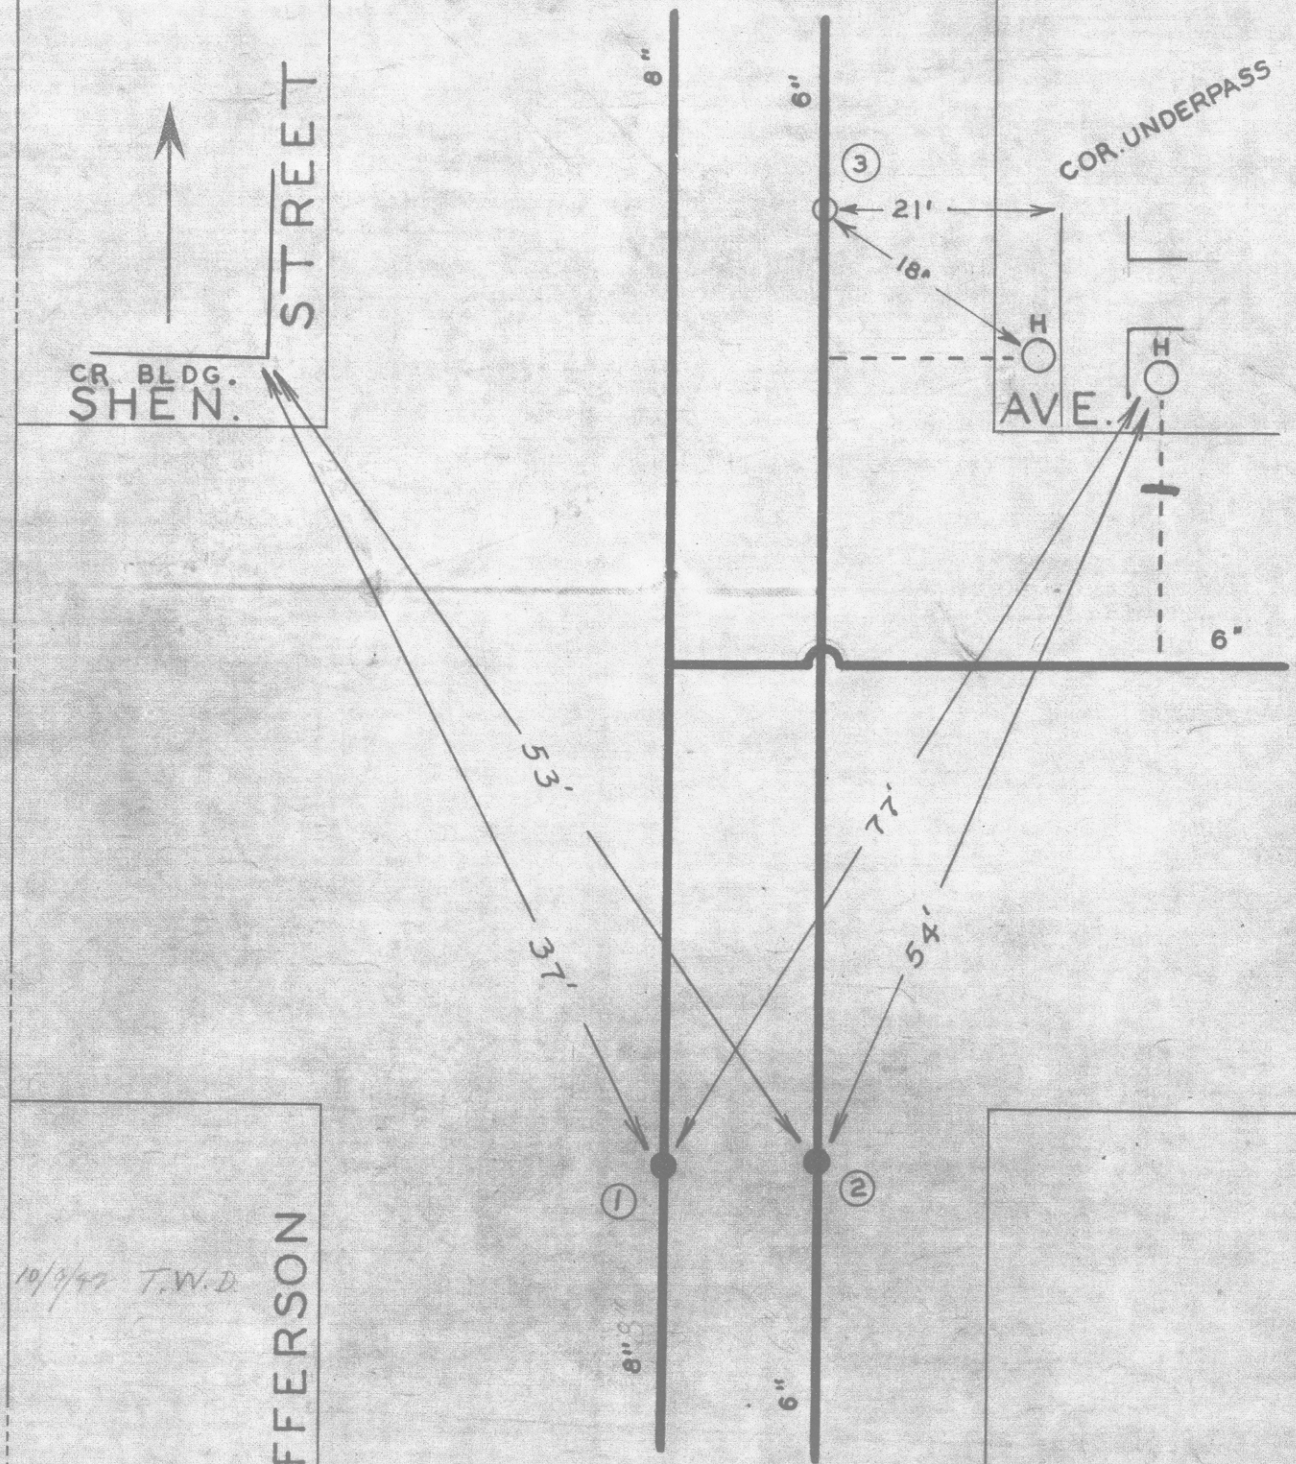

DATE	NO.	SIZE	MAKE	OPEN	TURNS
	1	8"			
	2	6"			
	3	1"	PITOT STA.		
	1	0	SPL		
	2	0	SPL		

10/3/47 T.W.D

CITY OF ROANOKE — WATER DEP'T

VALVE DIAGRAM

JEFFERSON ST. &

SHENANDOAH AVE. N. W.

OR N. E.

SEC. MAP 201

DATE DEC 13 1961 PAGE NO. N.W. 1